

ADDENDUM #2

REQUEST FOR PROPOSALS

FEASIBILITY STUDY FOR ADDITIONS AND ALTERATIONS OF THE RHODE ISLAND CONVENTION CENTER

RHODE ISLAND CONVENTION CENTER AUTHORITY

CLARIFICATIONS:

1. The sign-in sheet for the pre-proposal conference is attached to this addendum.
2. The North Garage plans are attached to this addendum for the proposers' use. Complete set will be provided to the awarded firm.

QUESTIONS:

Batch # 1

1. *Please confirm that all sub-consultants (associate architect, structural, MEP, etc...) that are not the prime contract holder will be allowed to pursue any further design work as identified in the feasibility study.*
 - a. Confirmed. Subconsultants are not excluded from any further work.
2. *Will the RICCA be able to provide further existing documentation for the facility including existing architectural, structural and MEP for the existing facility and any and all additions and renovations?*
 - a. All available documents will be provided to the awarded firm.
3. *Will the condition assessment be limited to the Convention Center proper or is Amica Mutual Pavilion also assumed to be in that scope of work?*
 - a. To be clear this is not a total condition assessment request of the RI Convention Center. This is a feasibility study to explore options for expansion and / or alterations or connections to adjacent properties. Connectivity to the AMP may be something the firms choose to explore. Sufficient review of the existing buildings will be needed to validate the feasibility of; and general concept of the options.

Batch # 2

1. *Is there a budget for design fees?*
 - a. No.
2. *Is there a budget for construction fees?*
 - a. No.

3. *During the walk through, the continuation of services from feasibility to construction documents of the architect was described. Could you please provide that information again as relayed by the state purchasing agent?*
 - a. The Convention center Authority is a quasi public entity. We follow in general the RI Purchasing guide lines which typically say the firm that does the feasibility study **may** be precluded from doing the construction phase documents. The Authority may wave that restriction. The State Purchasing Agent has said that if one firm is the lead and another is a subcontractor, those relationships can switch to comply with the State guidelines.
4. *Should we include the 3D scanning company in our proposal team?*
 - a. Forms should show their capacity to perform this, and not include the cost.
5. *Is there a time when all outlined services need to be completed by, or will that be determined by the selected team and RICCA, and the team's proposed schedule?*
 - a. The schedule will be determined with the successful firm.
6. *Will participating in the feasibility study preclude any prime firm and sub-consultants from participating in other services, such as OPM services, during the construction document, bidding, and construction administration phases?*
 - a. No.
7. *Is there a minimum of feasibility options that are expected for the Authority to review?*
 - a. The RFP refers to "several" initial concepts. We expect the successful firm can come up with multiple ideas for further exploration and the Authority, at a minimum of three for the final reports.

Batch # 3

1. *Jensen Hughes is mentioned as the fire and code compliance reviewer for the Authority. Should proposal carry an independent fee for fire and code compliance consultant as part of the consultant team or will we be able to use Jensen Hughes for high-level fire and code consulting during the study?*
 - a. Firms should carry their own choice of code compliance consultants for the high level code review for the studies. That may be whichever code consultant they choose. The Authority will not hire one directly.
2. *Please clarify whether selection for the feasibility study precludes the project team from pursuing the subsequent implementation project?*
 - a. See previous questions / answers.

3. *Are there WBE/MBE requirements for the study team?*
 - a. Not for the feasibility phase of the project.
4. *Please provide a list of the facilities condition reports for the existing building that will be made available to the successful proposer (e.g. Life Safety / Egress, Façade/Envelope, Structural or MEP Assessments, etc).*
 - a. We will provide at a minimum:
 1. All existing as built drawings
 2. An evaluation of the exterior of the building done by Building Enclosure Science in 2025
 3. Life Safety studies, and egress evaluation reports by Jensen Hughes
 4. An existing conditions report under way now by Walker Associates of the Convention Center loading dock
 5. A Smoke Evacuation Study of the building systems by Jensen Hughes.

Batch # 4

1. *Please confirm if Jensen Hughes will be contracted separately by RICCA to provide comments / support to the feasibility study team as it relates to complex code and life-safety strategies, and that we need not provide code consultancy services as part of our feasibility study proposal.*
 - a. See answer above regarding code consultants.
2. *The 5th bullet point on page 3 of 12 of the RFP lists “Security Service Provider” as one of the evaluation elements. Please confirm the scope of work does not include security services or security design.*
 - a. Change the wording from “Security Service Provider” to “the proposing firm”.
3. *Are there any Women, Minority, and/or Local business percentage requirements to be met in the delivery of the scope of services for the feasibility study?*
 - a. See question above.
4. *RFP lists food service consultants as one of the potential specialty consultants needed. In our experience this would be necessary at a future stage beyond feasibility, and at this stage we would propose working directly with the current food service provider for the facility for input. Please confirm food service consulting is not required at the feasibility stage.*
 - a. Confirmed, a food consultant is not required at this stage.

5. *The Exhibit C Hunden Study includes 3 options with additional hotel space. Is a new hotel to be considered as part of the scope of work for the current feasibility study RFP?*
 - a. The hotel would not be part of the budget, but the concept of a hotel should be discussed in the initial studies. The concept may be part of the final three the Authority may select.
6. *We understand from the Preproposal meeting that the project budget is not to exceed \$225 million. Please confirm this is the maximum project budget for the convention center expansion / renovation and that this number does not include any additional hotel space that may be part of the feasibility study.*
 - a. The \$225 million total project cost is the maximum the Authority will be able to borrow for any projects that come out of these studies. A hotel may or may not be part of the final concepts the Authority selects to move forward with.
7. *We understand from the preproposal meeting that the Lead firm contracted for the feasibility study will not be precluded from pursuing future (related) project opportunities with the Rhode Island Convention Center so long as they are a subconsultant to another firm who would be the Lead firm in future projects. Please confirm.*
 - a. See previous answers.

Batch #5

1. *Can you provide information regarding the interview phase of the selection process? i.e. shortlist date and tentative interview dates, and virtual vs. in-person.*
 - a. Short listed firms will be notified by EOB 11/19/25. Interviews for short listed firms are tentatively scheduled for the afternoon of 12/3/25. Exact times will be determined at a later date. An in-person interview is preferred. Remote attendance for some or all of the team is acceptable.
2. *Please confirm the selected consultant team is not precluded from pursuing the full design of the resulting study's recommendations.*
 - a. See previous answers.


END OF ADDENDUM #2

RICC FEASIBILITY STUDY RFP WALK THROUGH MEETING SIGN IN SHEET


ONLY ENTER THE PRIMARY CONTACT FOR ANY COMMUNICATIONS FOR EACH FIRM

TUESDAY OCTOBER 28, 2025 11 AM


COMPANY	CONTACT NAME	PHONE #	EMAIL ADDRESS
1. <u>POPULOUS</u>	<u>AARON BRUCKERHOFF</u>	<u>617.216.4918</u>	<u>AARON.BRUCKERHOFF@POPULOUS.COM</u>
2. <u>RLB</u>	<u>MICHAEL OREILLY</u>	<u>617-888-9948</u>	<u>michael.oreilly@os.rlb.com</u>
3. <u>ME ENGINEERS</u>	<u>BRIAN UNEKIS</u>	<u>303-507-0091</u>	<u>BRIAN.UNEKIS@ME-ENGINEERS.COM</u>
4. <u>TVS</u>	<u>PAUL MCKEEVER</u>	<u>734-846-7454</u>	<u>pmckeever@tvsdesign.com</u>
5. <u>ZDS</u>	<u>JEFFREY PORTER</u>	<u>401-680-6699</u>	<u>JPORTER@ZDS.COM</u>
6. <u>DBVW</u>	<u>MICHAEL VIVEIROS</u>	<u>CELL 401.258.8884</u>	<u>MVIVEIROS@DBVW.COM</u>
7. <u>Vision 3</u>	<u>PAUL HANSEN</u>	<u>508-840-9018</u>	<u>PHANSEN@VISION3ARCHITECTS.COM</u>
8. <u>LLB ARCHITECTS</u>	<u>BRIAN VALENTINE</u>	<u>401 421 7715</u>	<u>bvalentine@llbarch.com</u>
9. <u>TOULOUKIAN TOULOUKIAN</u>	<u>TED TOULOUKIAN</u>	<u>617-834-6065</u>	<u>ttouloukian@ttarch.com</u>
10. _____	_____	_____	_____
11. _____	_____	_____	_____
12. _____	_____	_____	_____

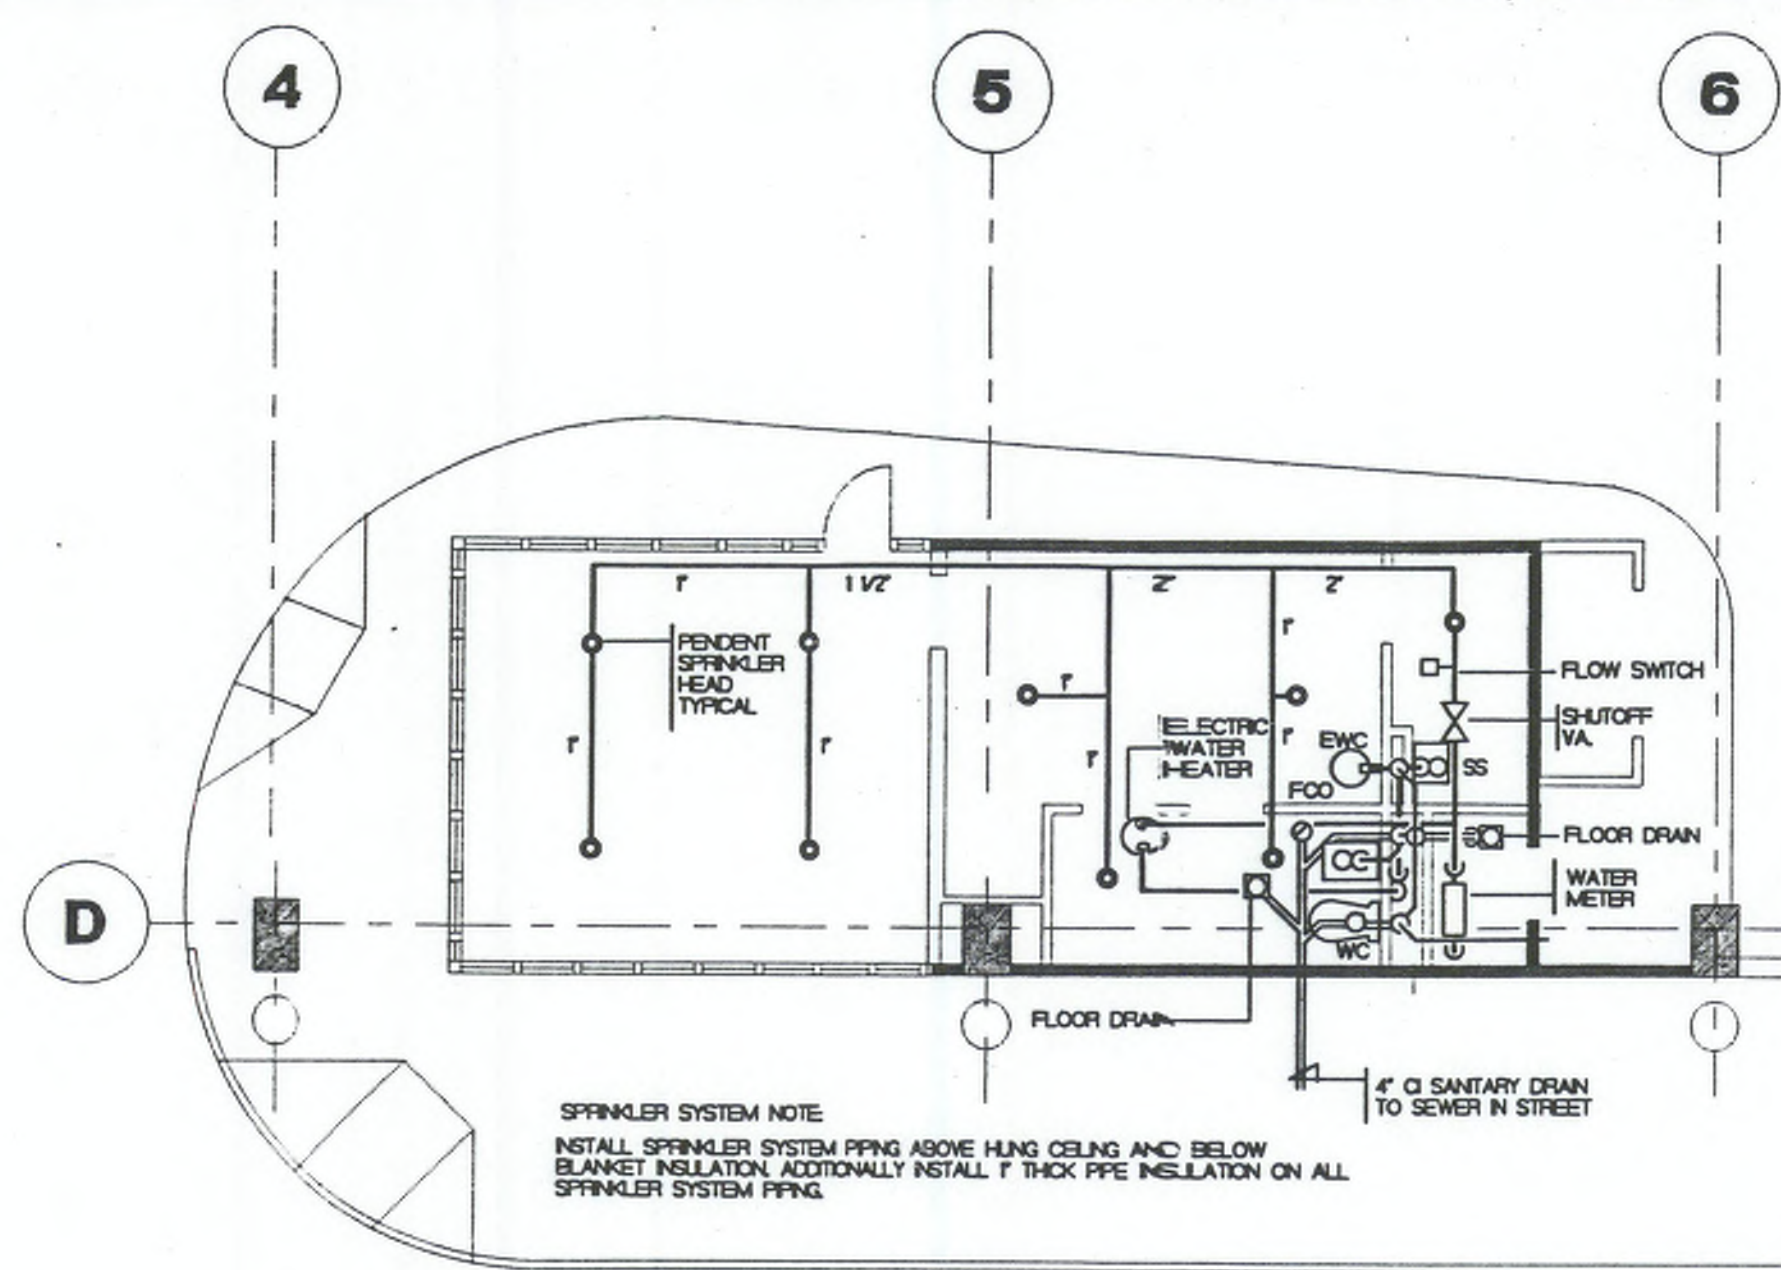


1 PART PLAN - OFFICES PLUMBING
SCALE: 1/8" = 7'-0"

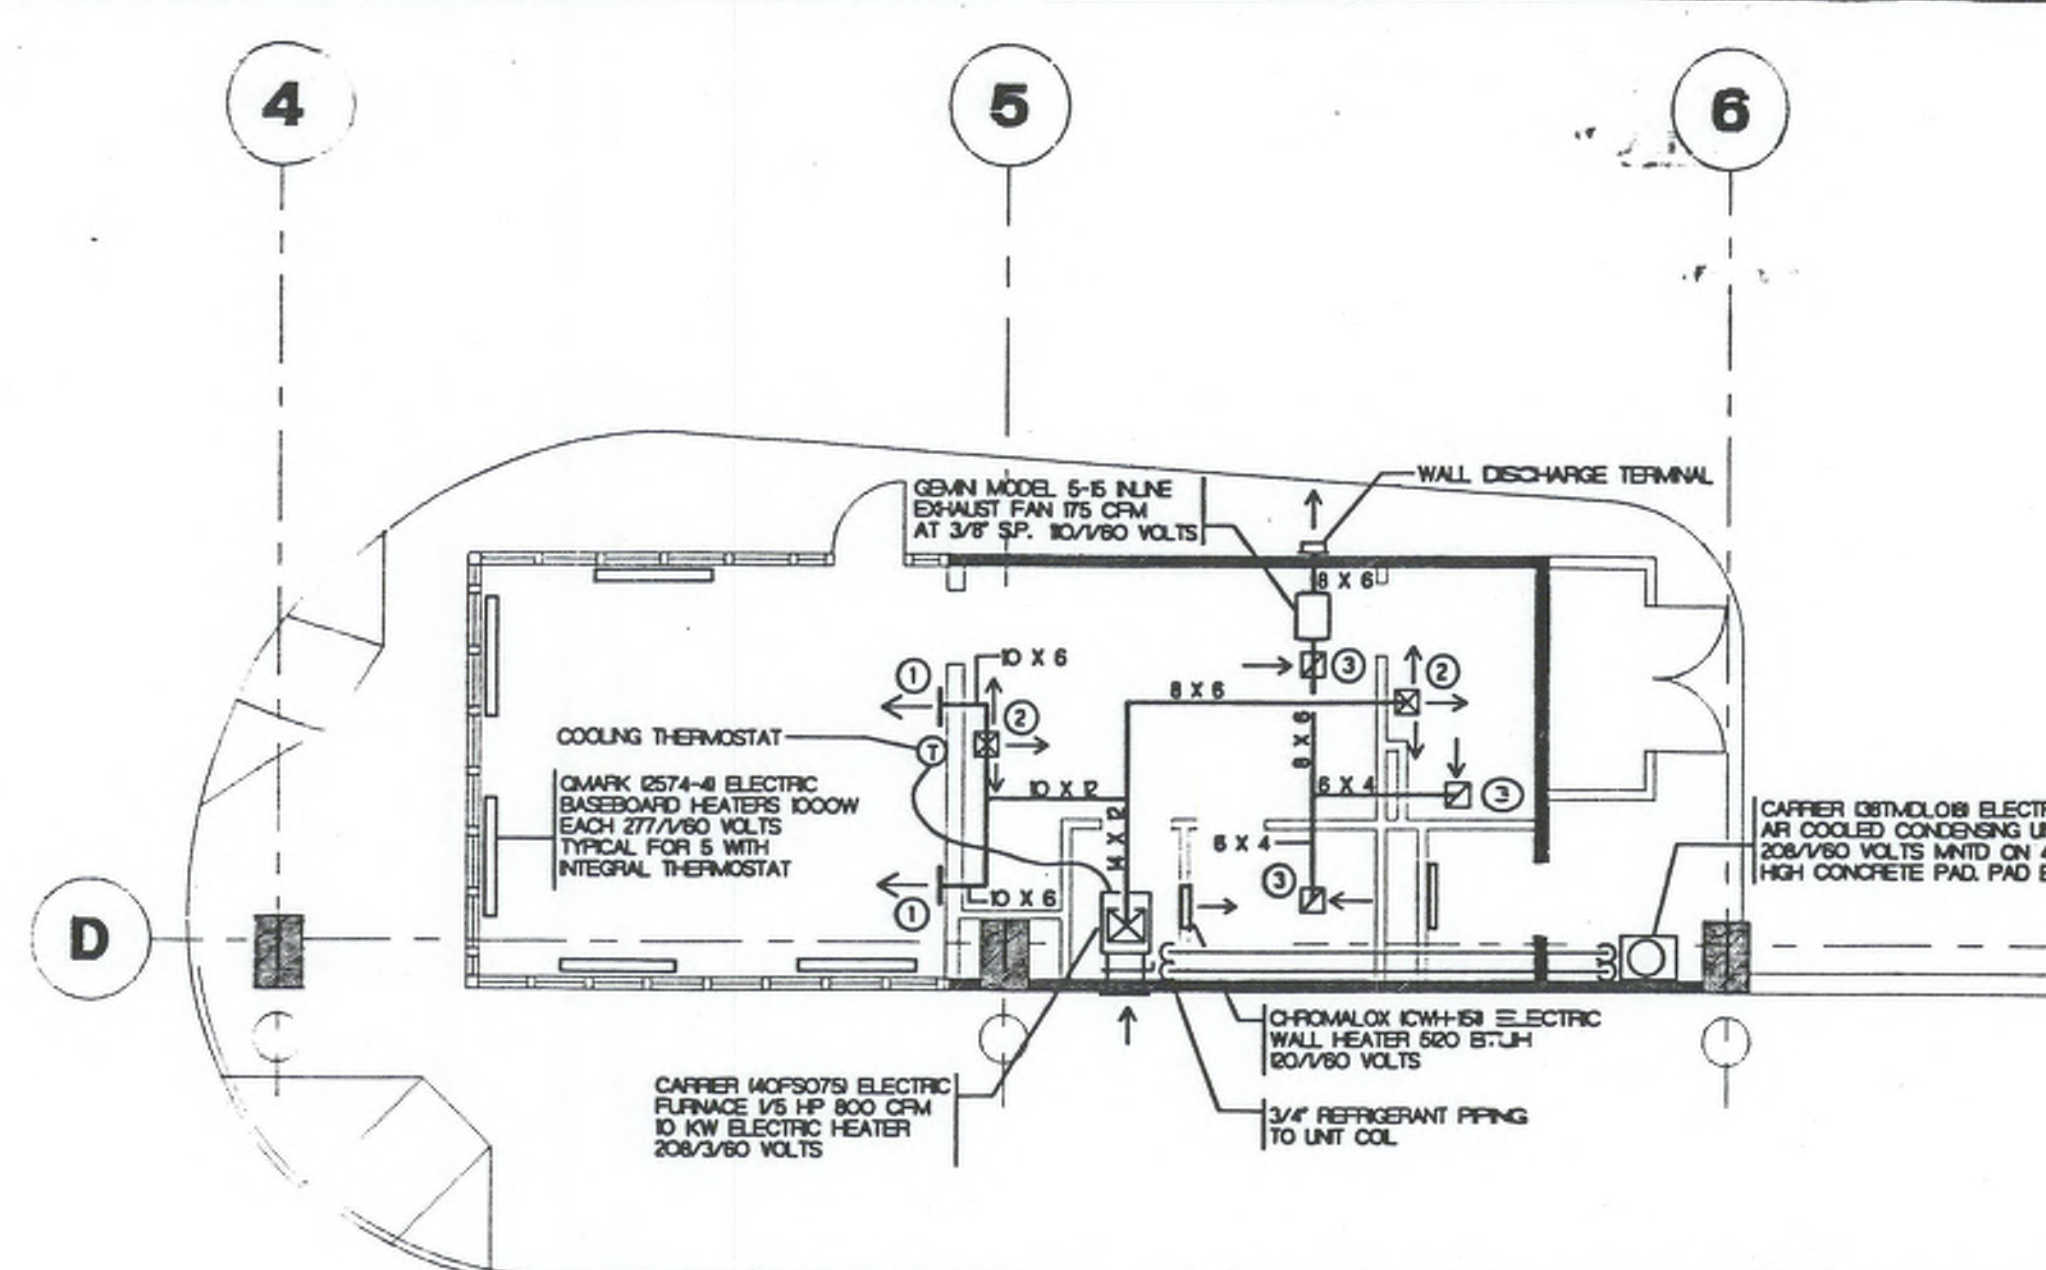

2 PART PLAN - OFFICES HVAC
SCALE: 1/8" = 7'-0"

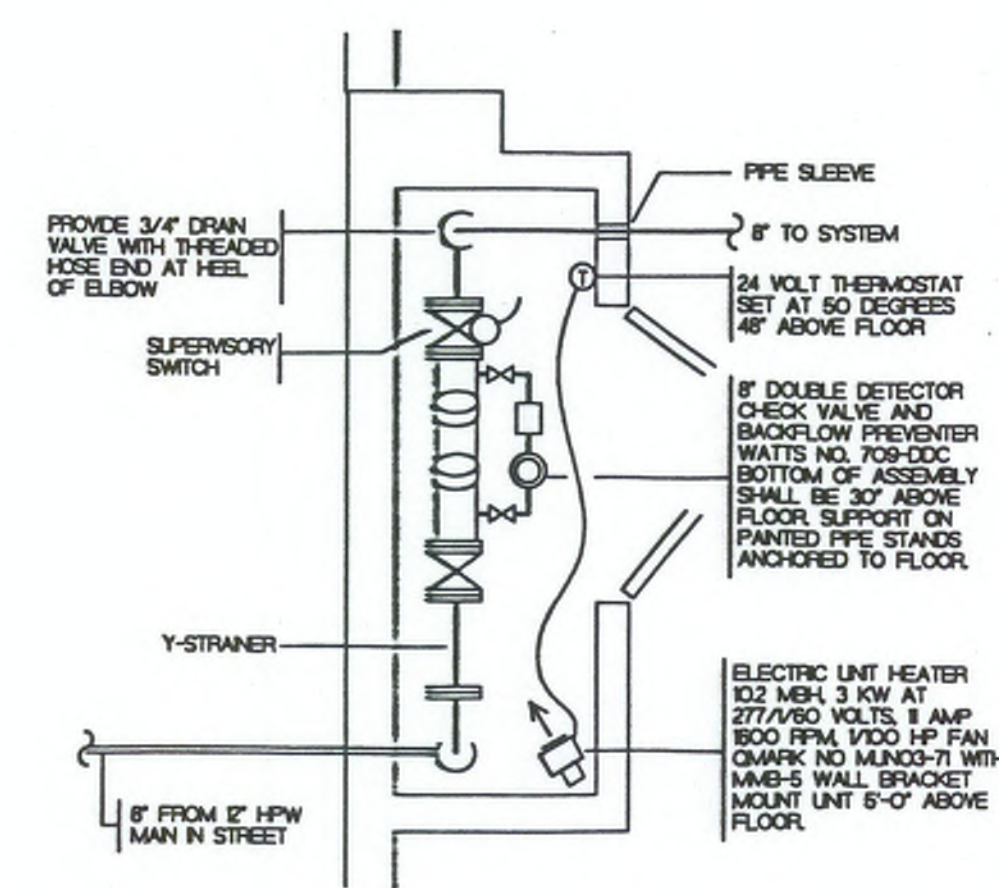


3 PART PLAN WATER ROOM
SCALE: 1/4" = 1'-0"

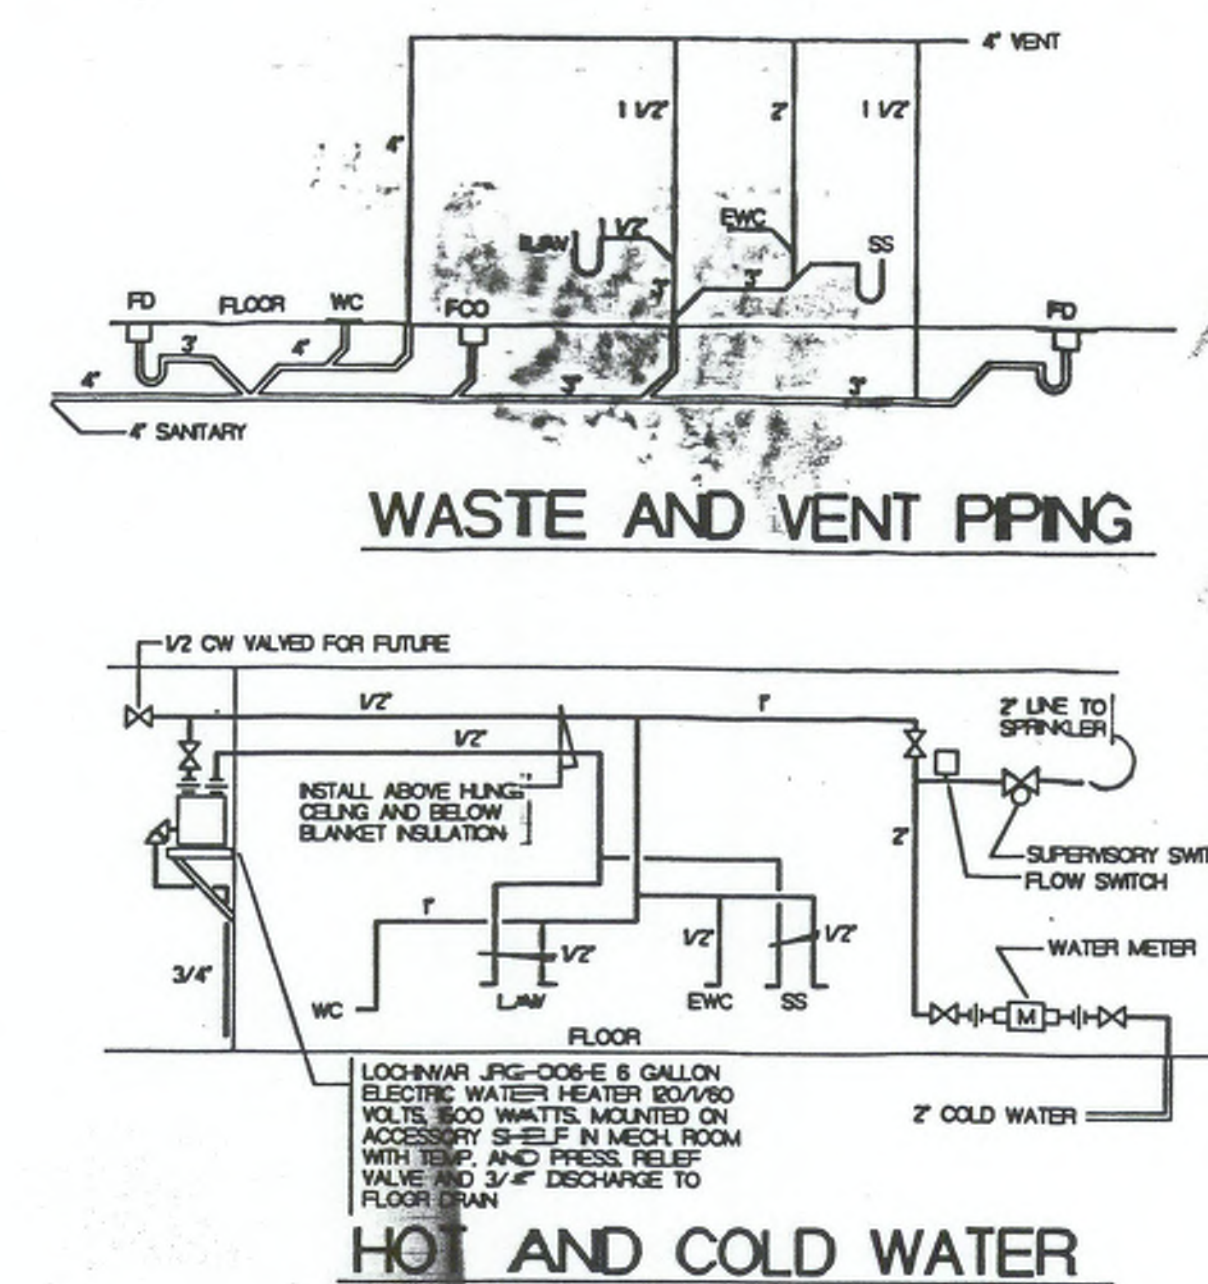


4 RISER DIAGRAMS
DIAGRAMATIC

NOTES


1. MANHOLE COVER TO BE BOLTED AND GAS TIGHT.
2. THE GAS-SAND TRAP TO BE LOCATED AND CONSTRUCTED SO THAT SURFACE WATER WILL BE EXCLUDED.
3. INLET PIPE SHALL BE AT LEAST 4" ABOVE NORMAL WATER LINE.
4. NEW TRAP TO BE FILLED WITH CLEAN WATER PRIOR TO USE.
5. OUTLET SHALL BE AT LEAST THREE FEET BELOW SURFACE.
6. ALL OIL AND GASOLINE SHALL BE REMOVED BEFORE CLEANING AND MUST NOT BE DISCHARGED INTO SEWER SYSTEM.
7. WROUGHT-IRON STEPS SHALL BE SPACED 8" APART.
8. TRAP SHALL BE CONSTRUCTED ONE FOOT IN PLACE CONCRETE IF SOLID CONCRETE BLOCKS WITH FULL MORTARED JOINTS HORIZONTAL AND VERTICAL PLASTERED INSIDE AND OUT OR RED BRICK MASONRY PLASTERED ON INSIDE. JOINTS AND CORNER JOINTS USED SHALL BE PLASTERED. PLASTER SHALL BE 1 PART CEMENT AND 2 PARTS SAND. COARSE BRICK HOLLOW CONCRETE OR OTHER BLOCK MASONRY SHALL NOT BE USED.

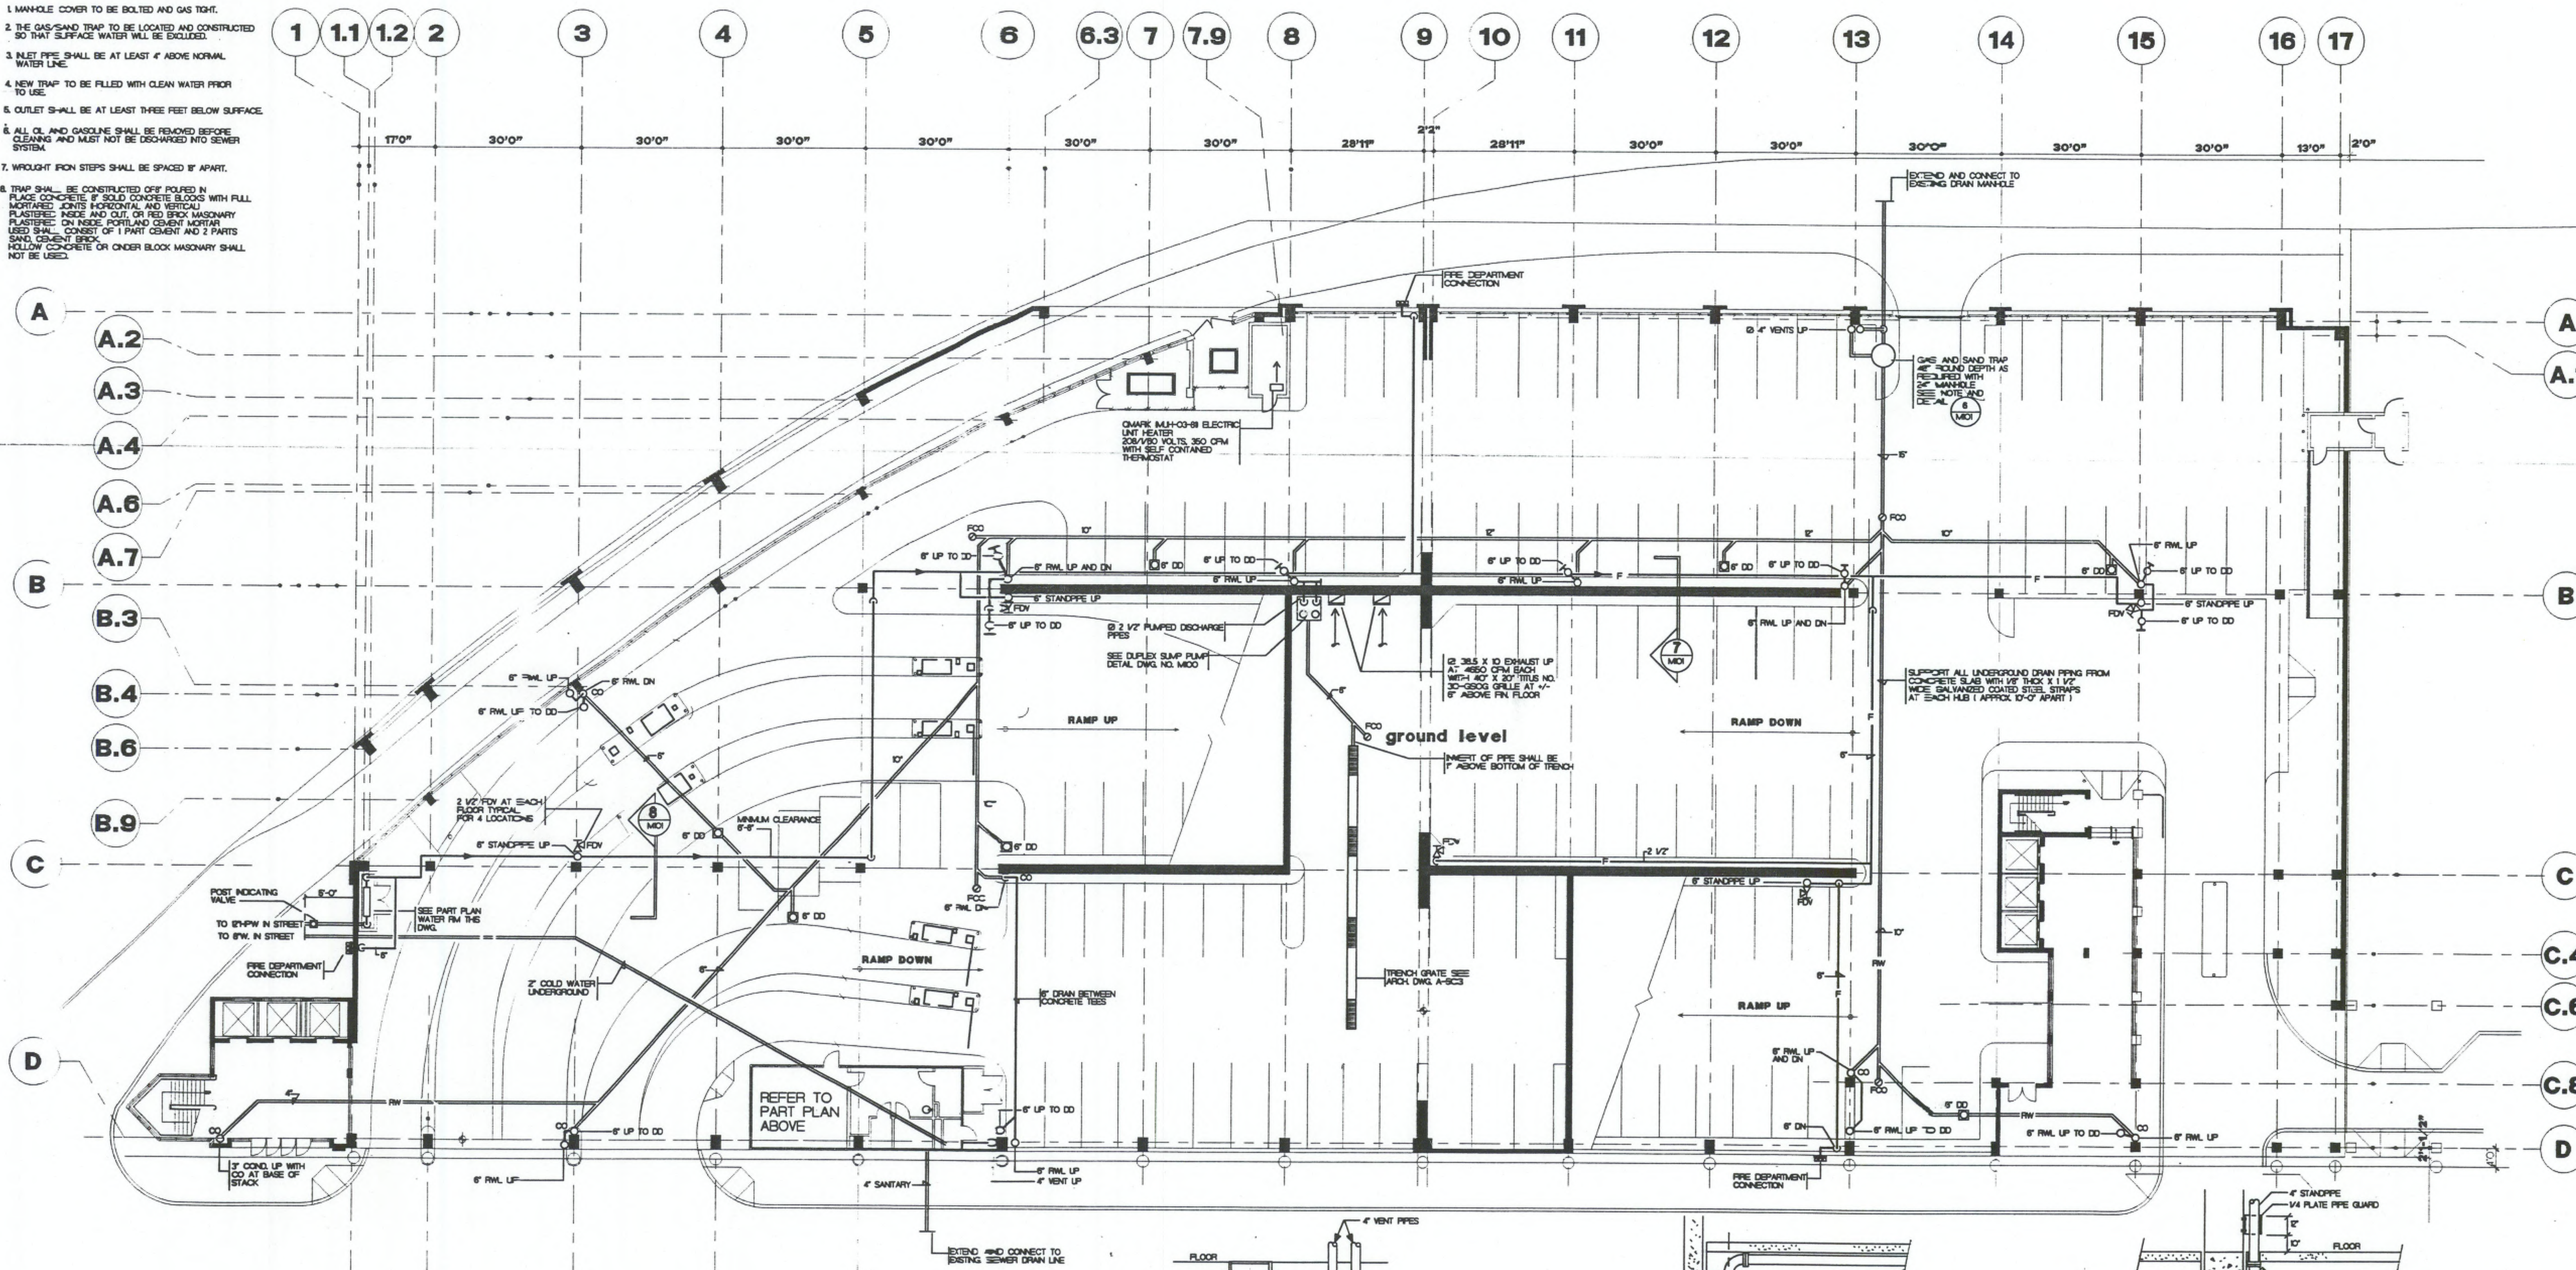


5 GROUND FLOOR PLAN (EL + 10) @ H.P. TYP.

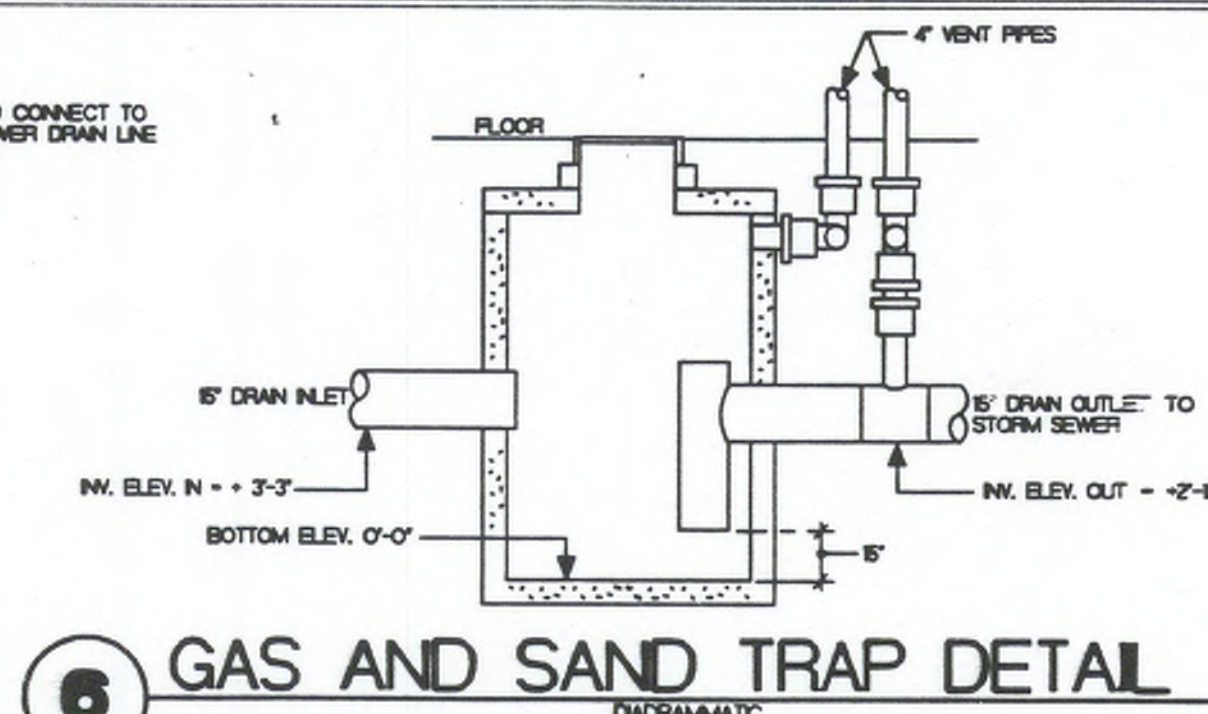

6 GAS AND SAND TRAP DETAIL
DIAGRAMATIC

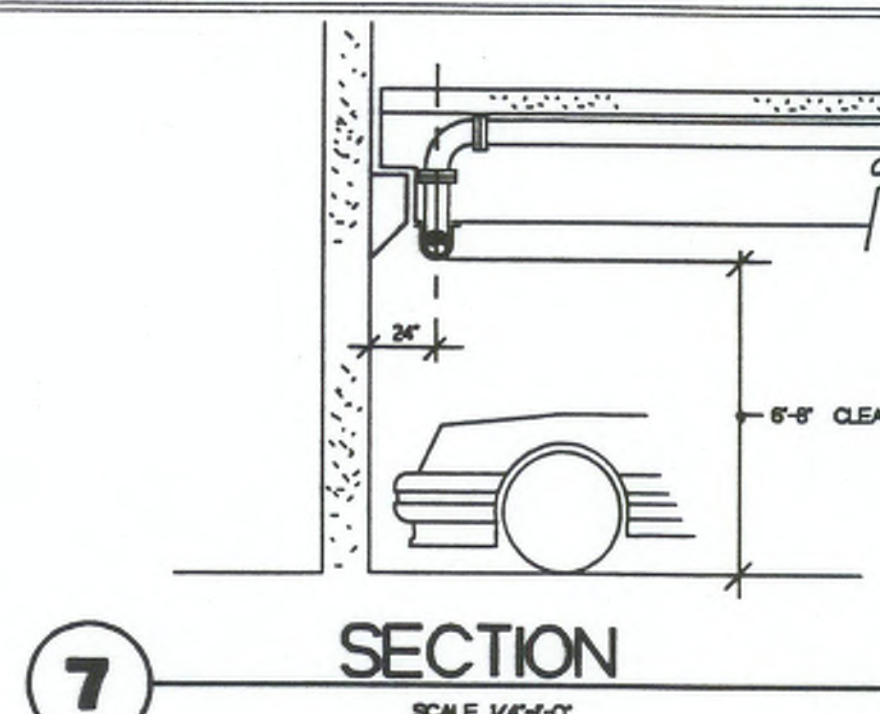

7 SECTION
SCALE: 1/4" = 1'-0"

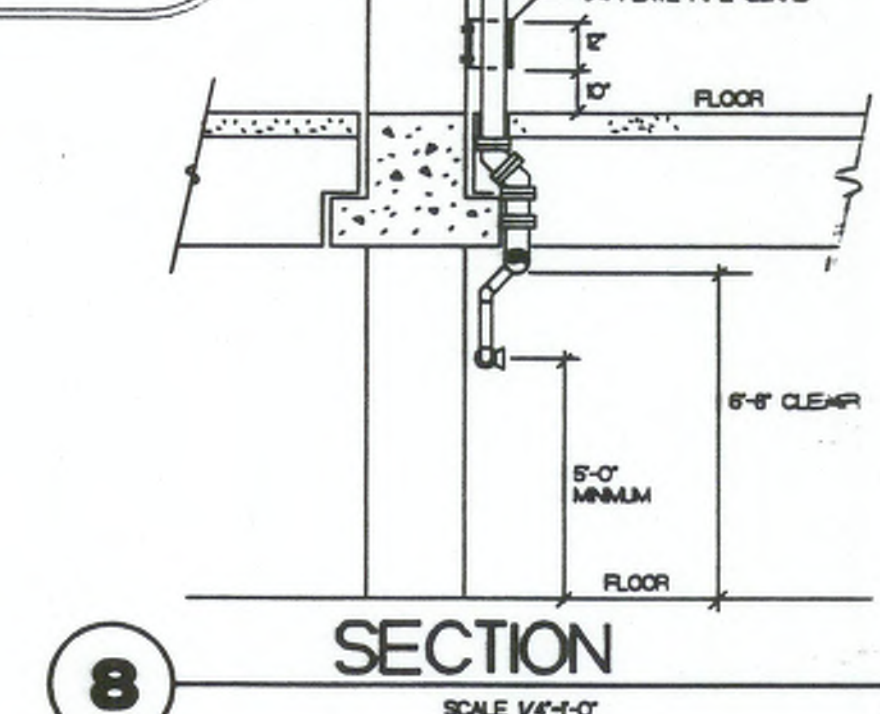

8 SECTION
SCALE: 1/4" = 1'-0"

NORTH PARKING STRUCTURE
CONVENTION CENTER COMPLEX
PROVIDENCE RHODE ISLAND

A METRO PARTNERS DEVELOPMENT FOR THE CONVENTION CENTER AUTHORITY

CONSTRUCTION MANAGER
Marshall Contractors Inc.
75 Newtong Avenue
Rumford, RI 02916
401-438-3500




Boston
Buffalo New York
St. Louis Washington

Cannon Boston Inc.
Architects and Engineers
148 State Street
Boston, MA 02109
617-742-5440
Fax 617-722-9832

Vernese Hanger Brustin Inc.
Civil Engineers/Surveyors
530 Broadway
Providence, RI 02909
401-272-8100


Desman Associates
Structural Engineers/Parking Garage Consultants
307 Fifth Avenue
New York, N.Y. 10016
212-686-6360

The SWA Group
Landscape Architects
71 Boylston Street
Boston, MA 02116
617-266-4703

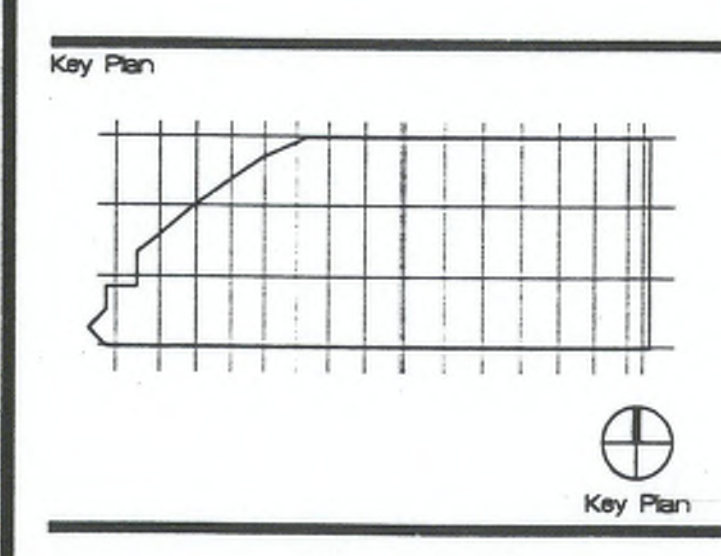


MAY 2, 1994 AS-BUILT
Revision Date Issued for
10 SEPT. 1992 T=15'-0"
Drawn by Checked by
DWD P=_____
PROJECT NO.
903.06
Drawing Title
GROUND FLOOR PLAN
LEVEL 1
AS BUILT
Drawing No.


M.101

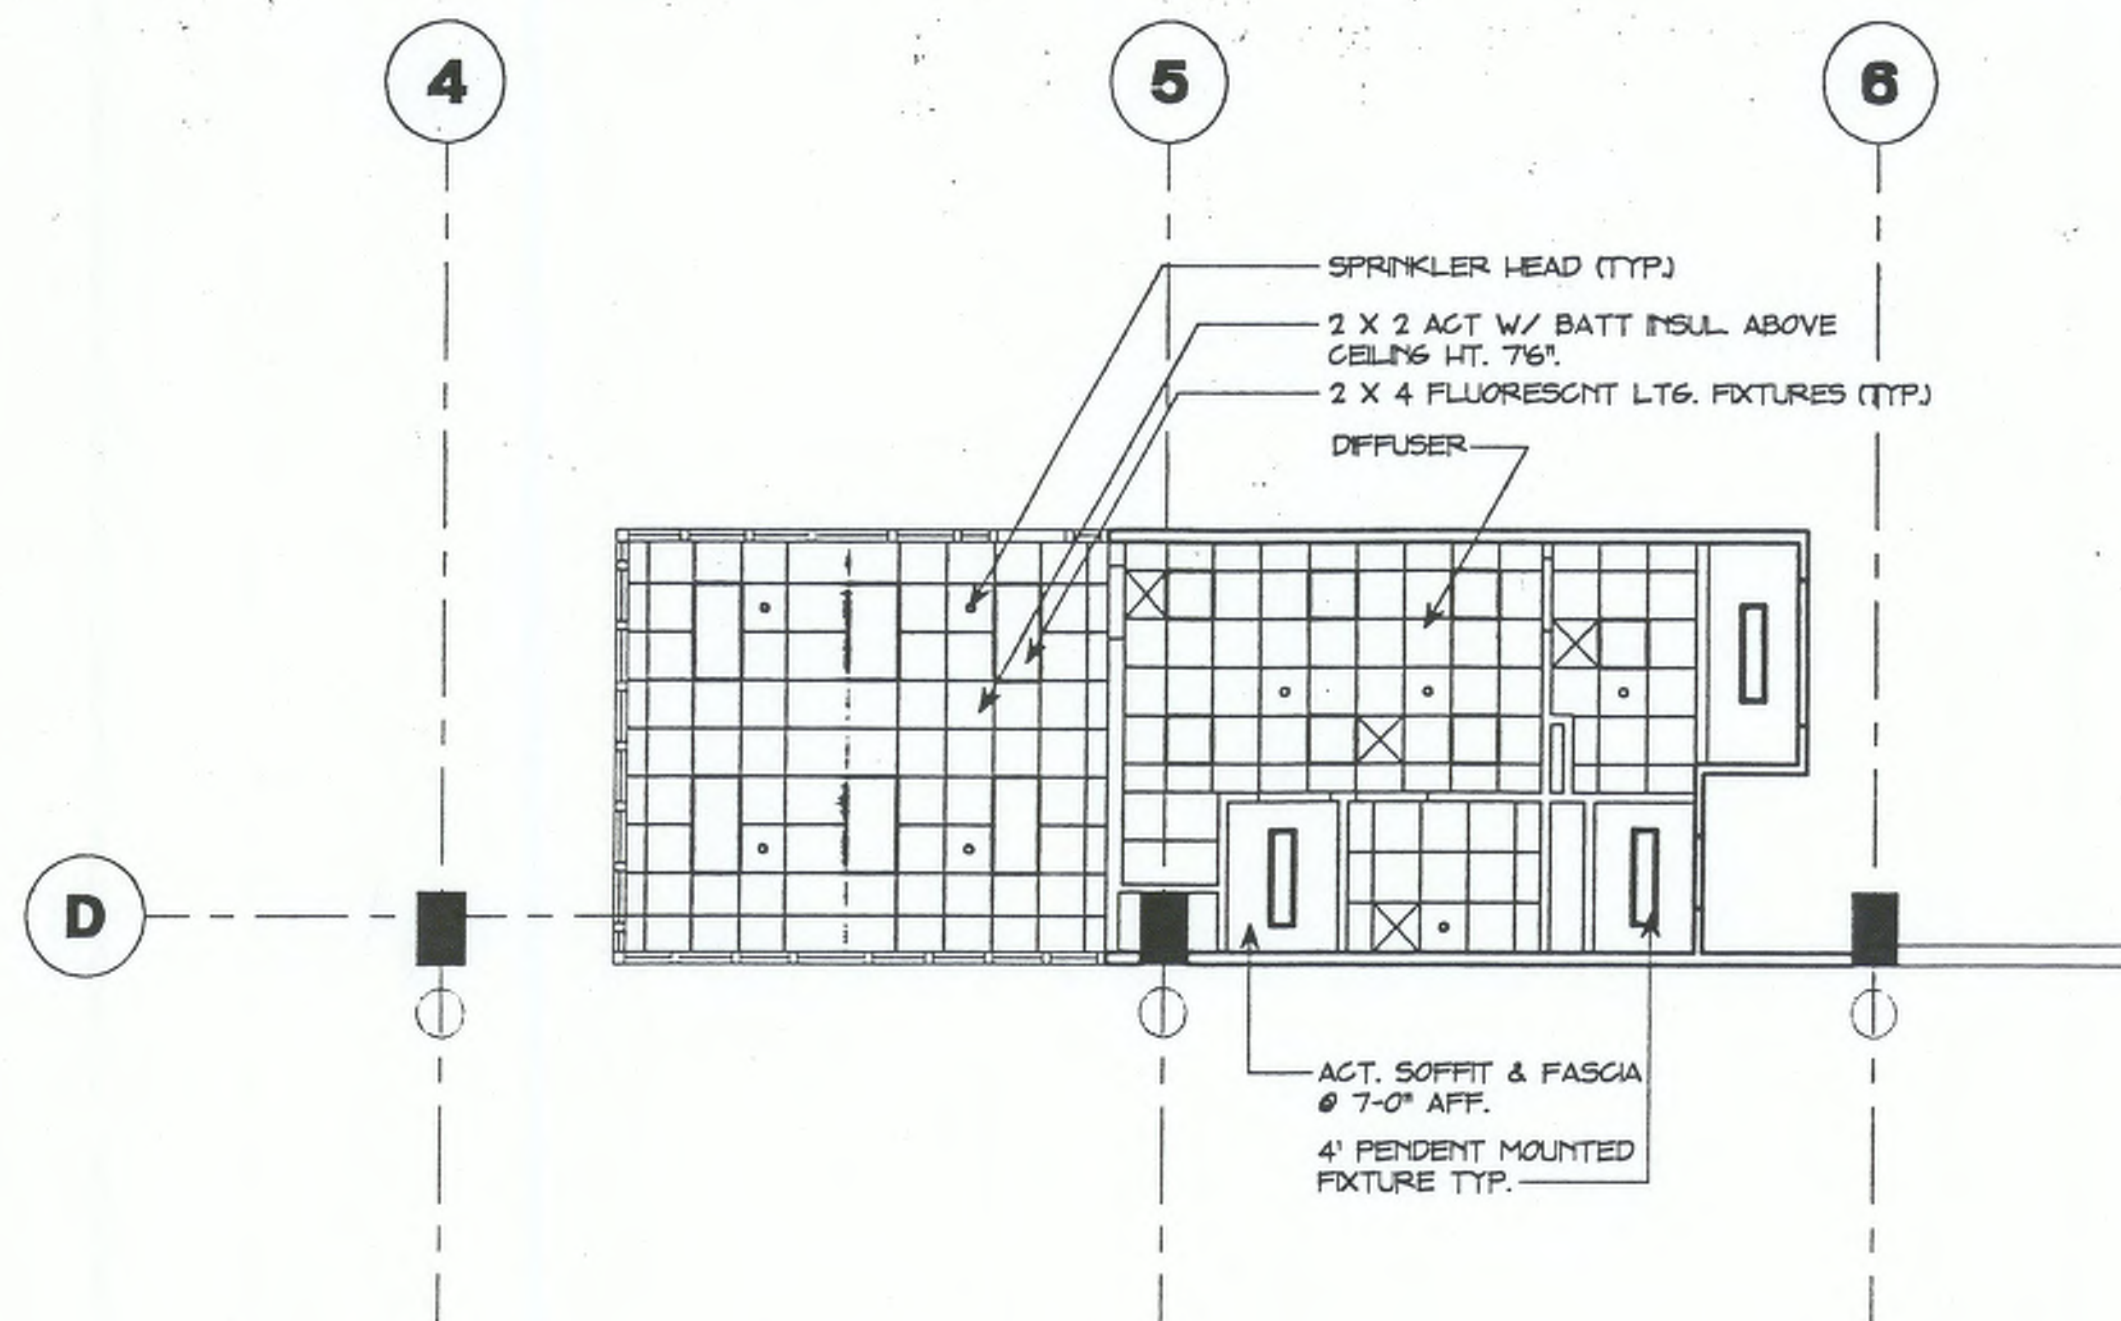

1 REF. CLG. PLAN - OFFICE
SCALE: 1/8" = 1'-0"

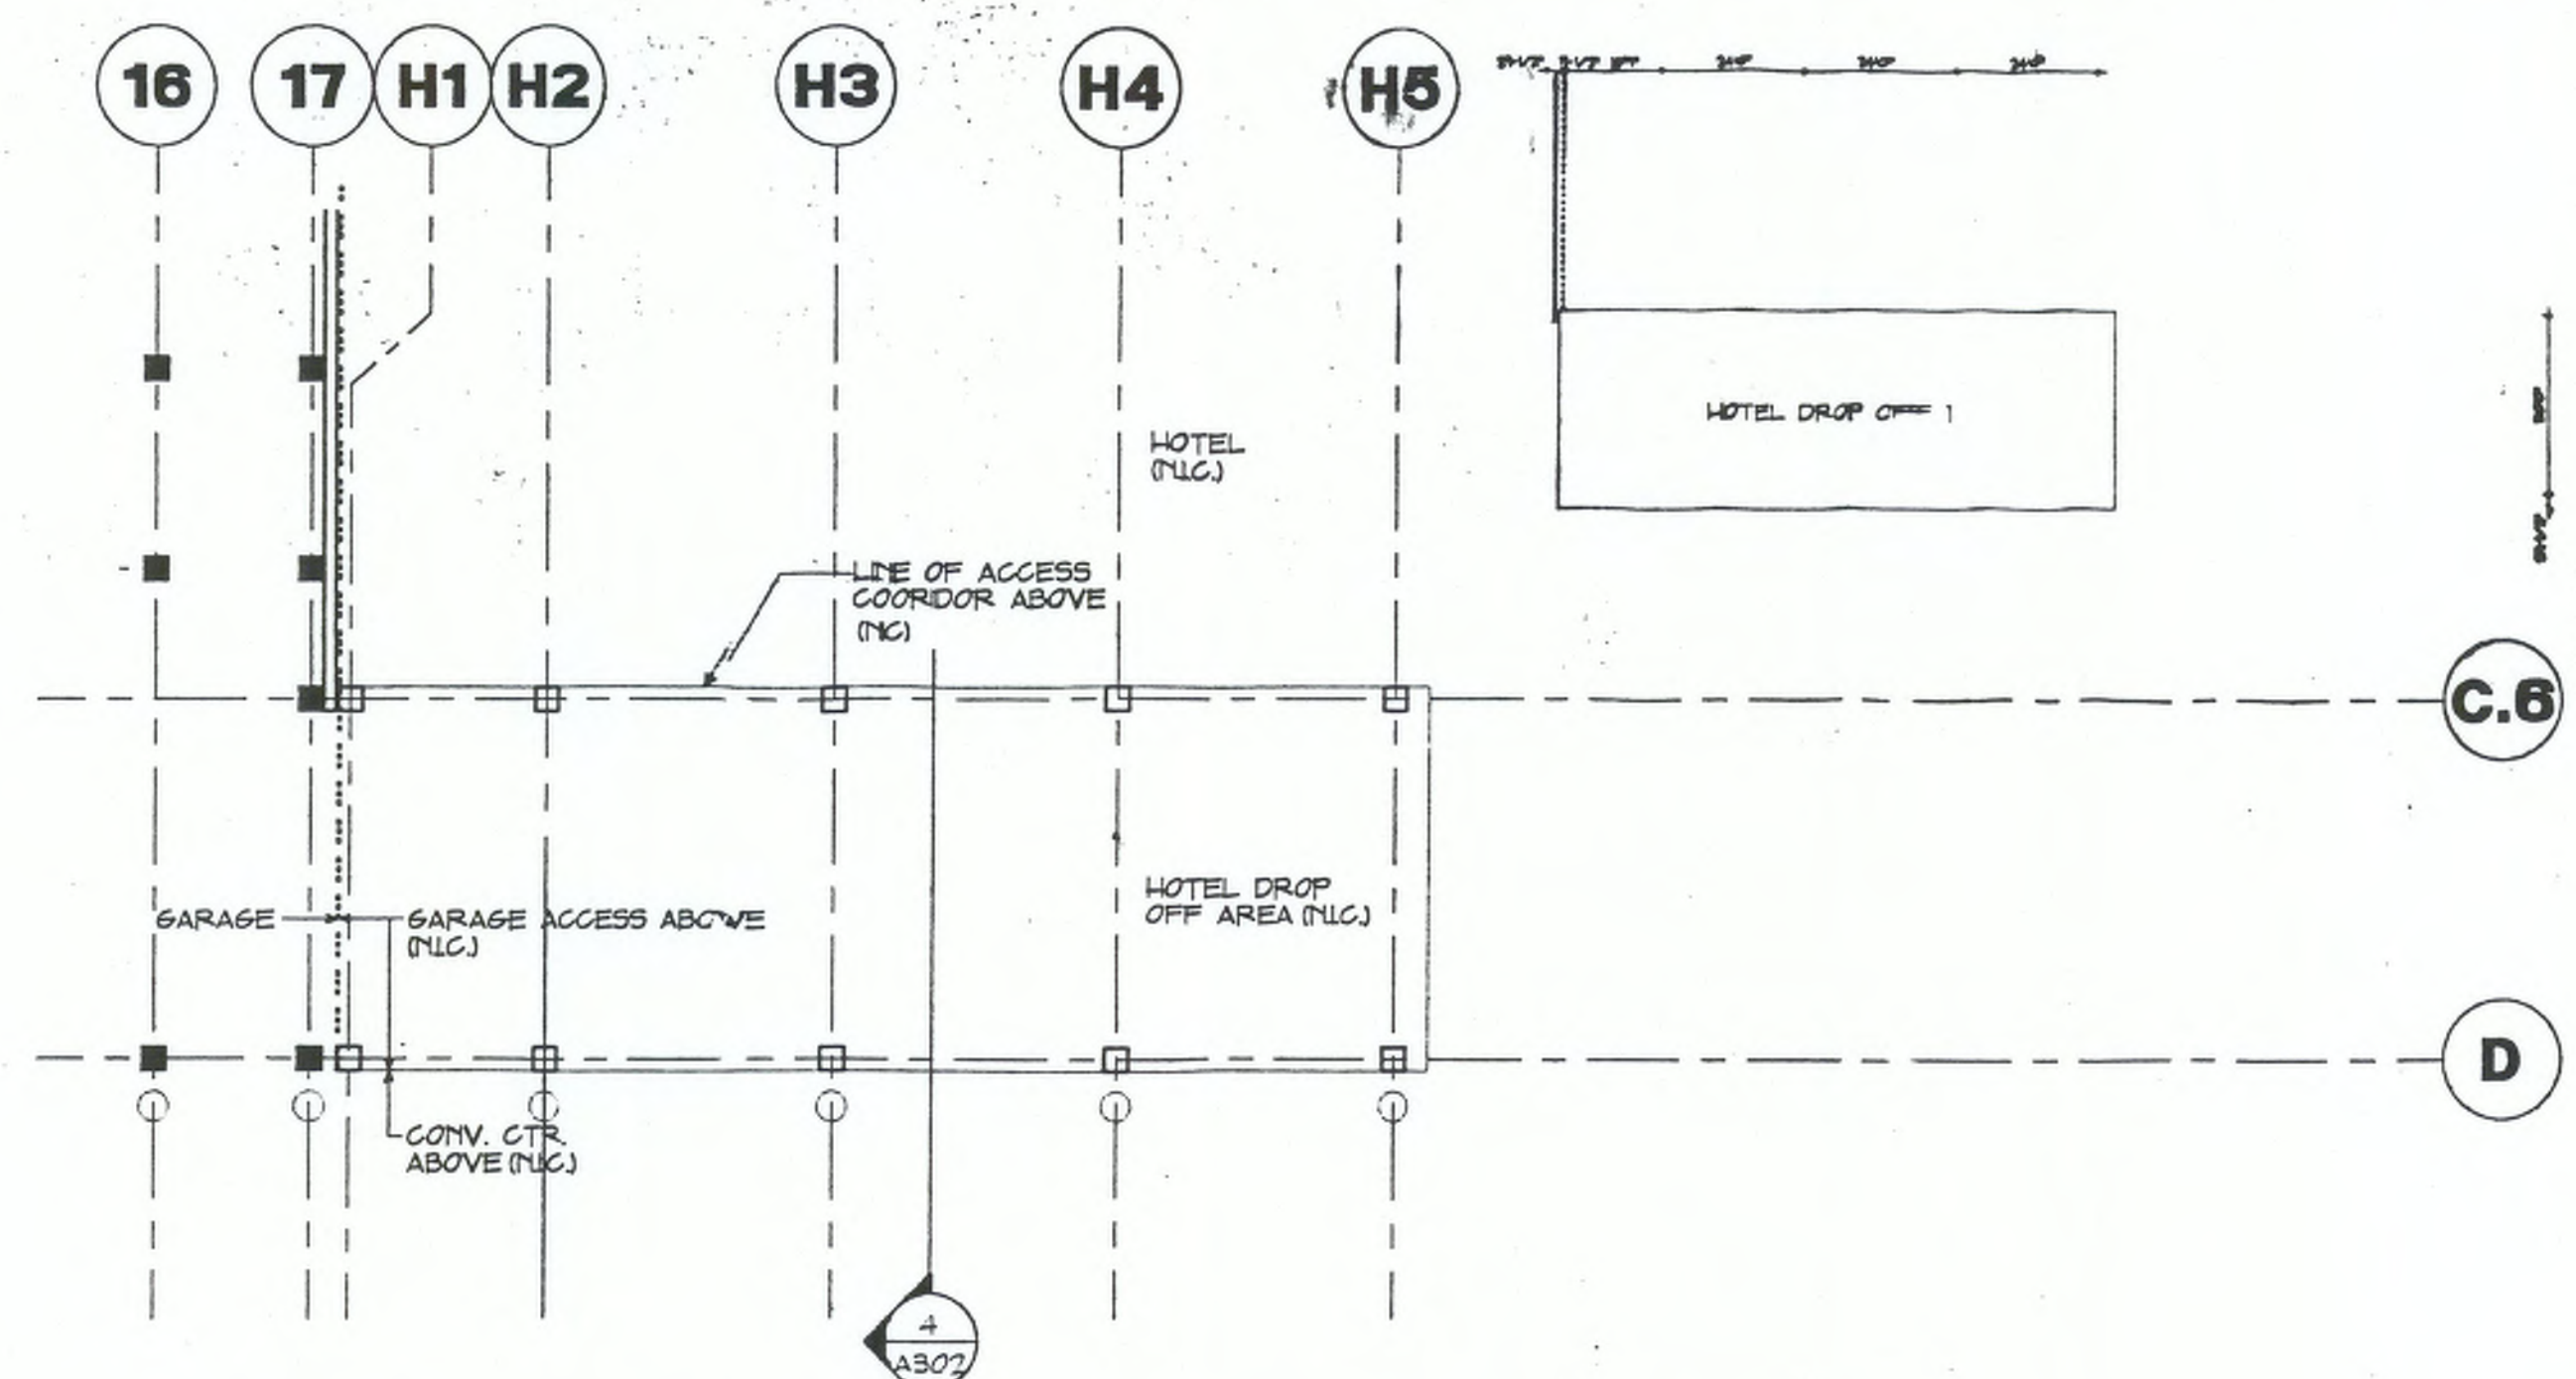

2 PART PLAN - HOTEL DROP OFF

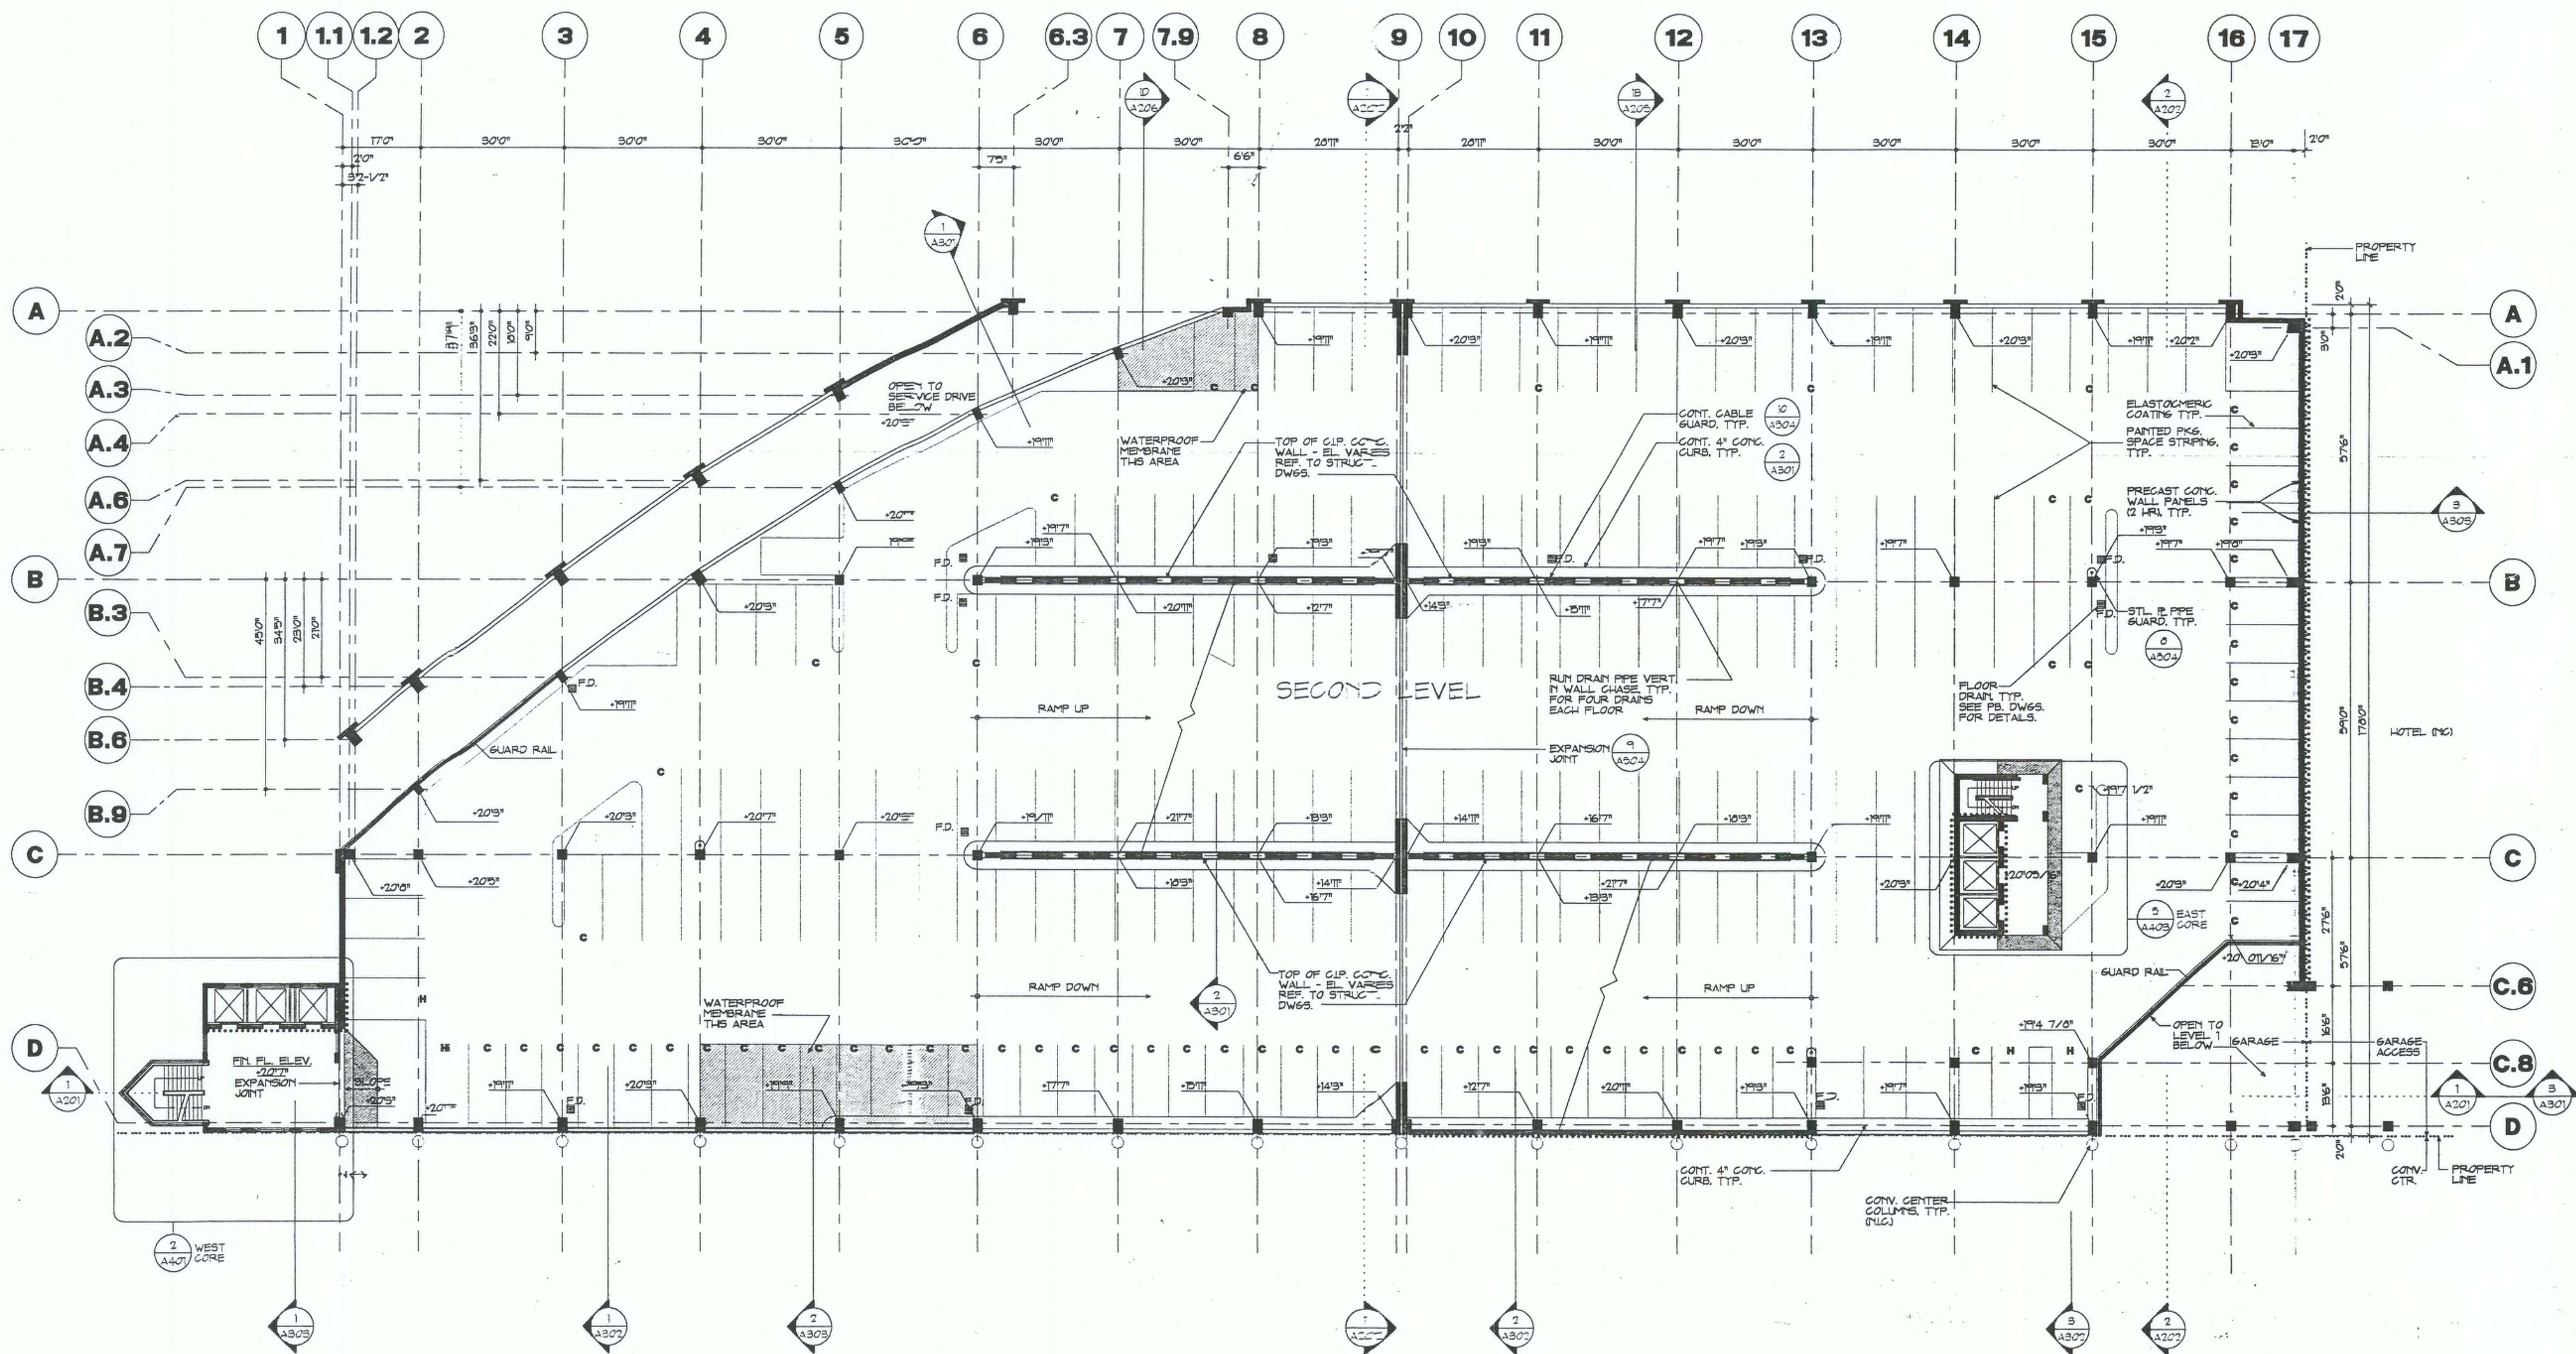

3 LEVEL 2 (EL. + 20')

209 PARKING SPACES

NORTH PARKING STRUCTURE

CONVENTION CENTER
COMPLEX
PROVIDENCE
RHODE ISLAND

A METRO PARTNERS
DEVELOPMENT FOR
THE CONVENTION
CENTER AUTHORITY

CONSTRUCTION MANAGER

Marshall Contractors Inc.
75 Newman Avenue
Rumford, RI 02918
401-438-3500



Boston
Buffalo New York
St. Louis Washington

Cannon Boston Inc.

Architects and Engineers
748 State Street
Boston, MA 02099
617-742-5440
Fax: 617-723-8832

Versace Hengen Brustin Inc.

Civil Engineers/Surveyors
530 Broadway
Providence, RI 02909
401-772-8000


Destman Associates

Structural Engineers/Parking Garage Consultants
307 Fifth Avenue
New York, NY 10016
212-685-5300

The SWA Group

Landscape Architects
71 Boylston Street
Boston, MA 02116
617-268-4703

Key Plan

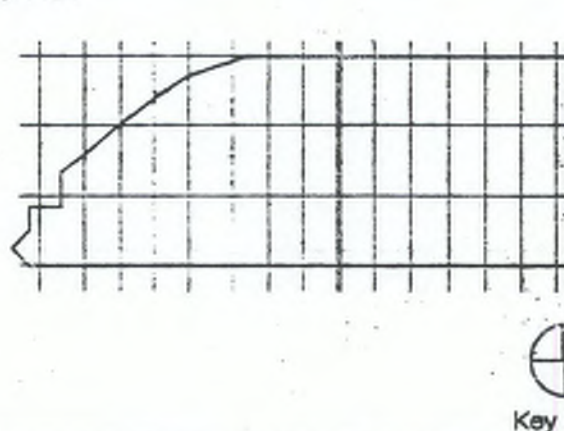

MAY 2, 1994 AS-BUILT

Revision	Date	Issued for
10 SEPT. 1992	1-16'-0"	Scale
Drawn by	Checked by	
RJ	JB/GV	
Project No.		
90106		
Drawing Title		
FLOOR PLAN		
LEVEL 2		
AS BUILT		

Drawing No.

A.102


NORTH PARKING STRUCTURE

CONVENTION CENTER
COMPLEX
PROVIDENCE
RHODE ISLAND

A METRO PARTNERS
DEVELOPMENT FOR
THE CONVENTION
CENTER AUTHORITY

CONSTRUCTION MANAGER
Marshall Contractors Inc.

75 Newman Avenue
Rumford, RI 02918
(401) 438-3500

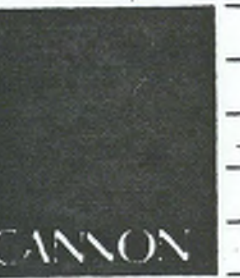


Boston
Buffalo New York
St. Louis Washington

Cannon Boston Inc.
Architects and Engineers
148 State Street
Boston, MA 02109
617 742-5440
Fax 617 722-8832

Vanasse Hangen Brustlin Inc.
Civil Engineers/Surveyors
530 Broadway
Providence, RI 02909
(401) 272-8000

Desman Associates
Structural Engineers/Parking Garage Consultants
307 Fifth Avenue
New York, NY 10016
(212) 686-5300


The SWA Group
Landscape Architects
71 Boylston Street
Boston, MA 02116
(617) 268-4703

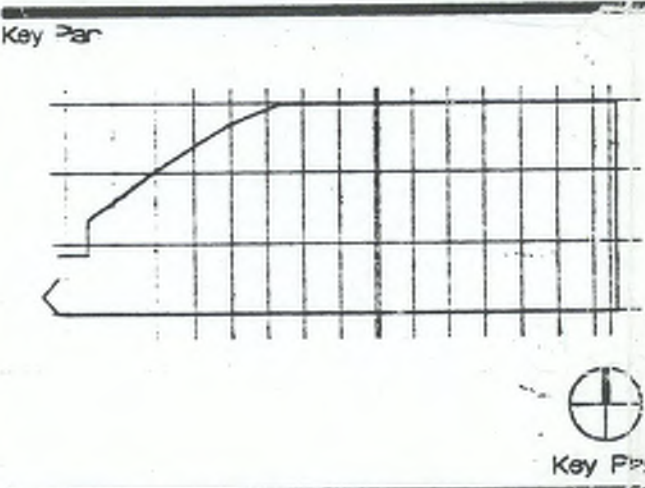


MAY 2, 1994 AS-BUILT
Revision Date Issued for
10 SEPT. 1992 Scale 1"=16'-0"
Drawn by Checked by
GV JB
Project No.
90306
Drawing Title

FLOOR PLAN
LEVEL 3
AS BUILT

A.103

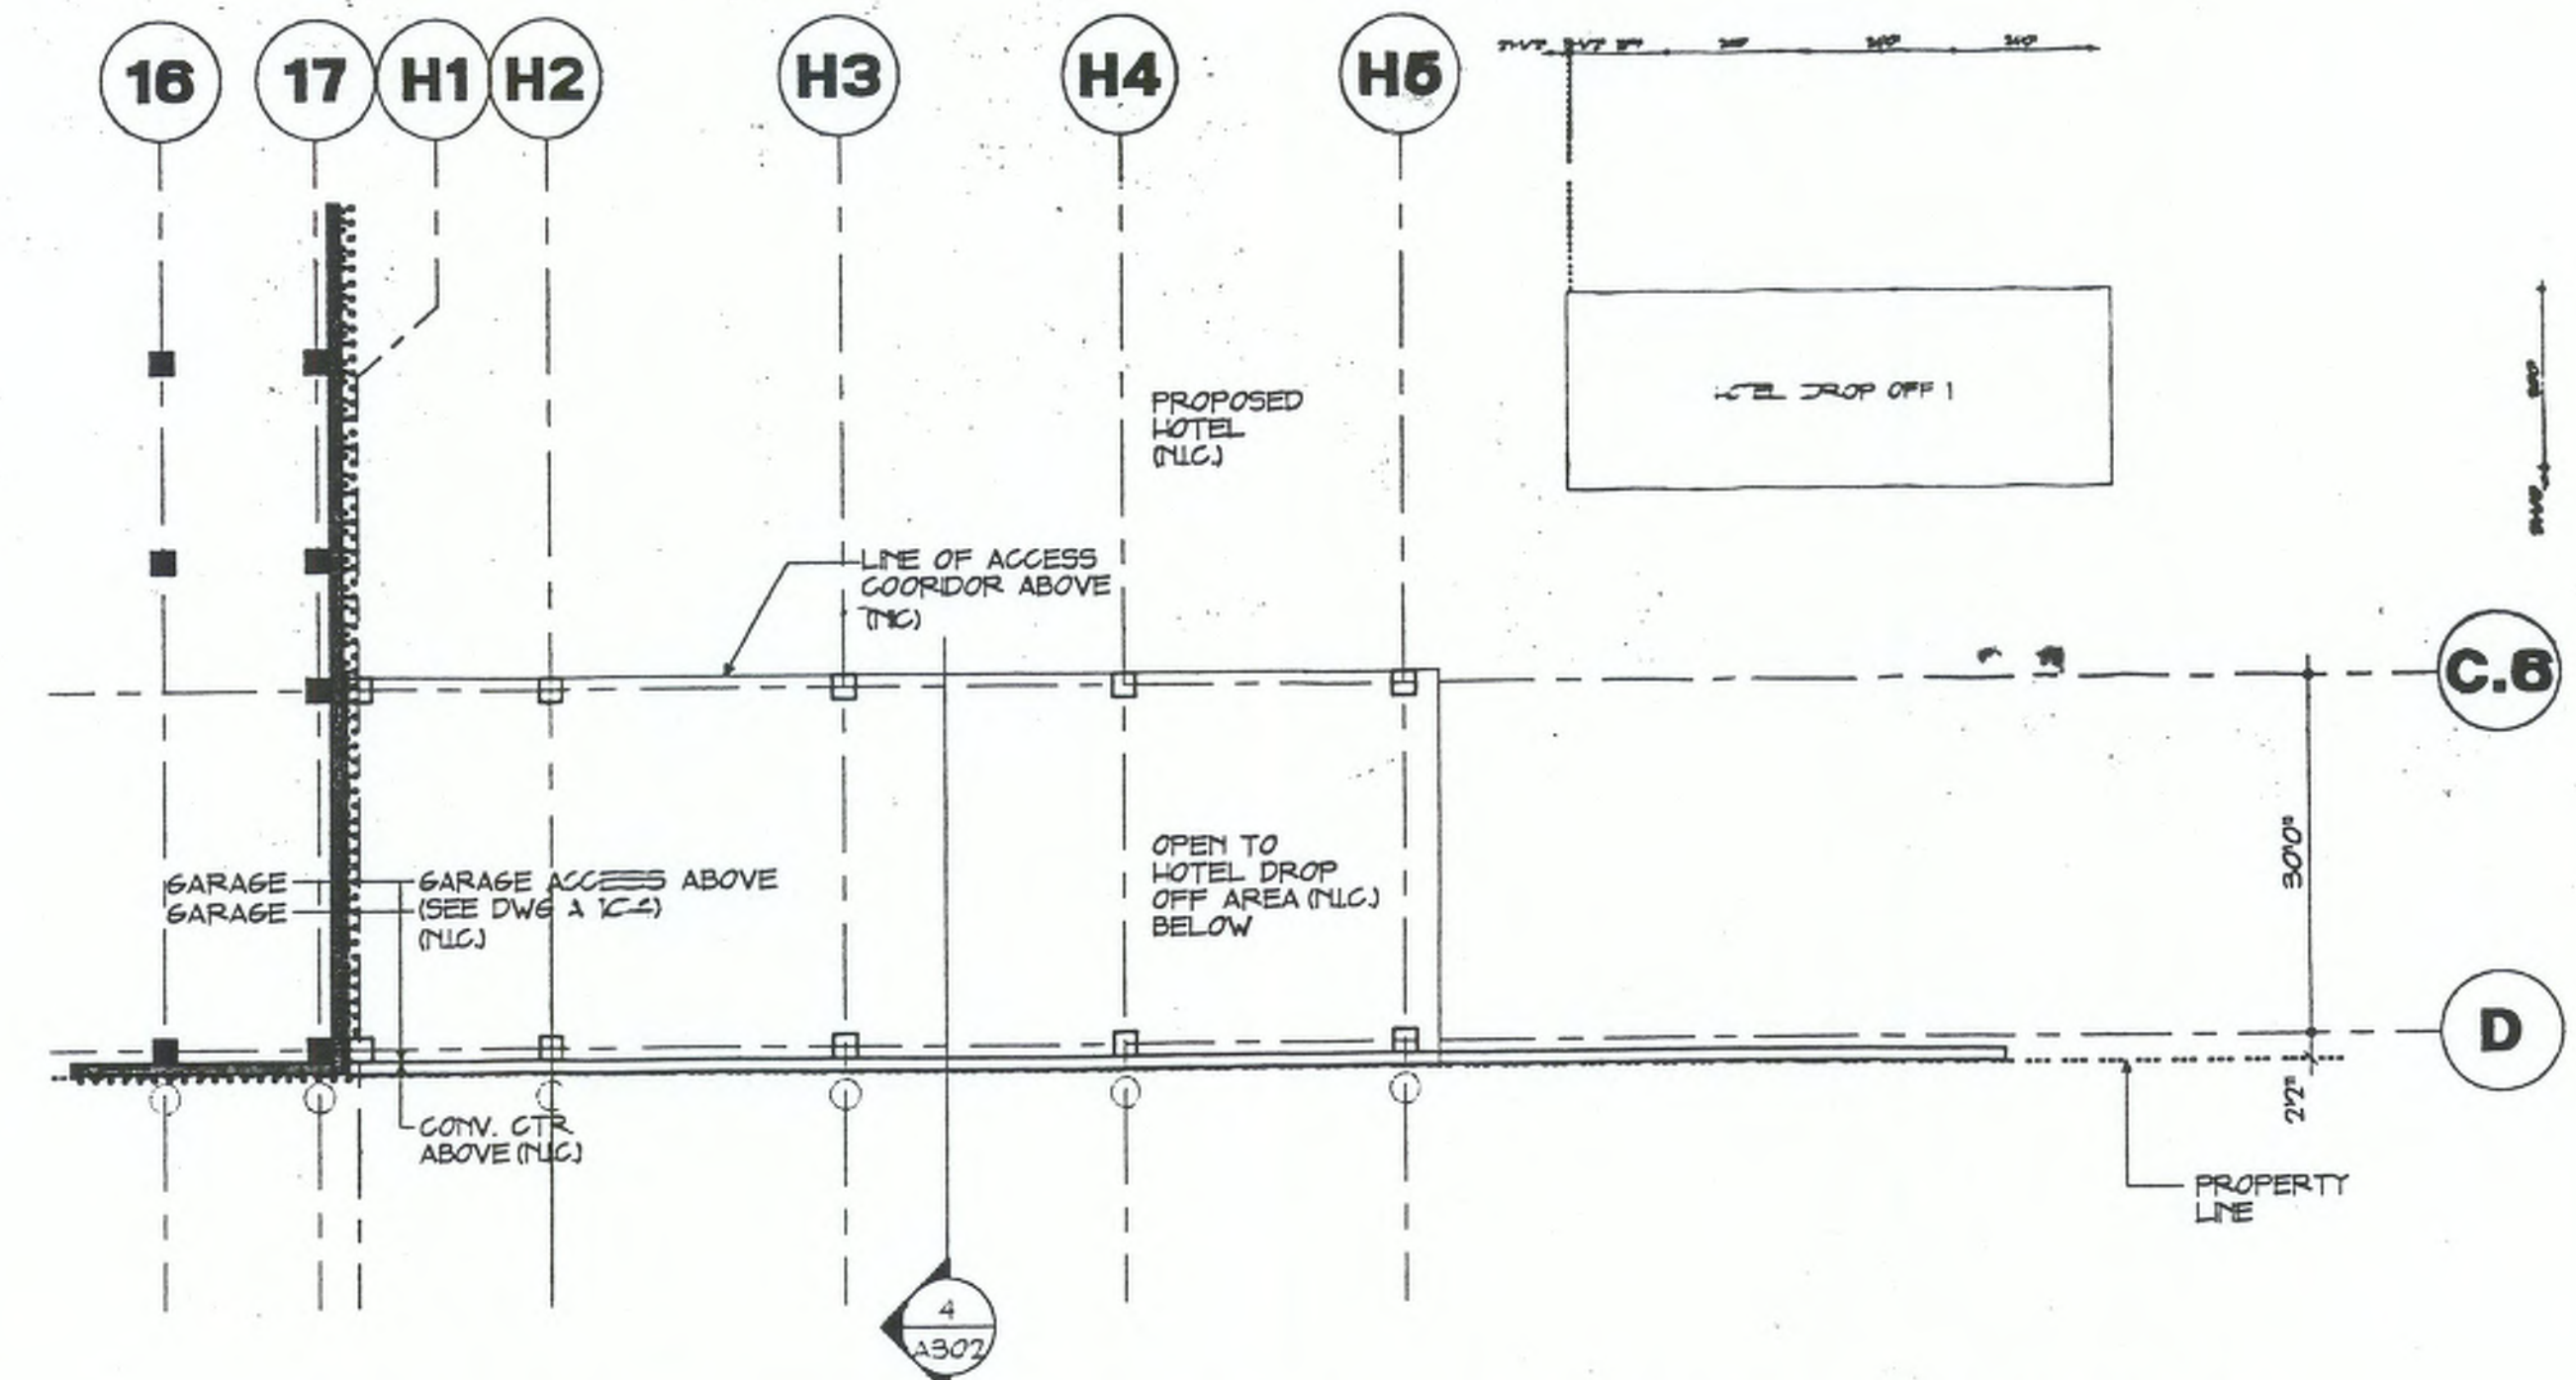


① REFLECTED CEILING PLAN - HOTEL DROP OFF

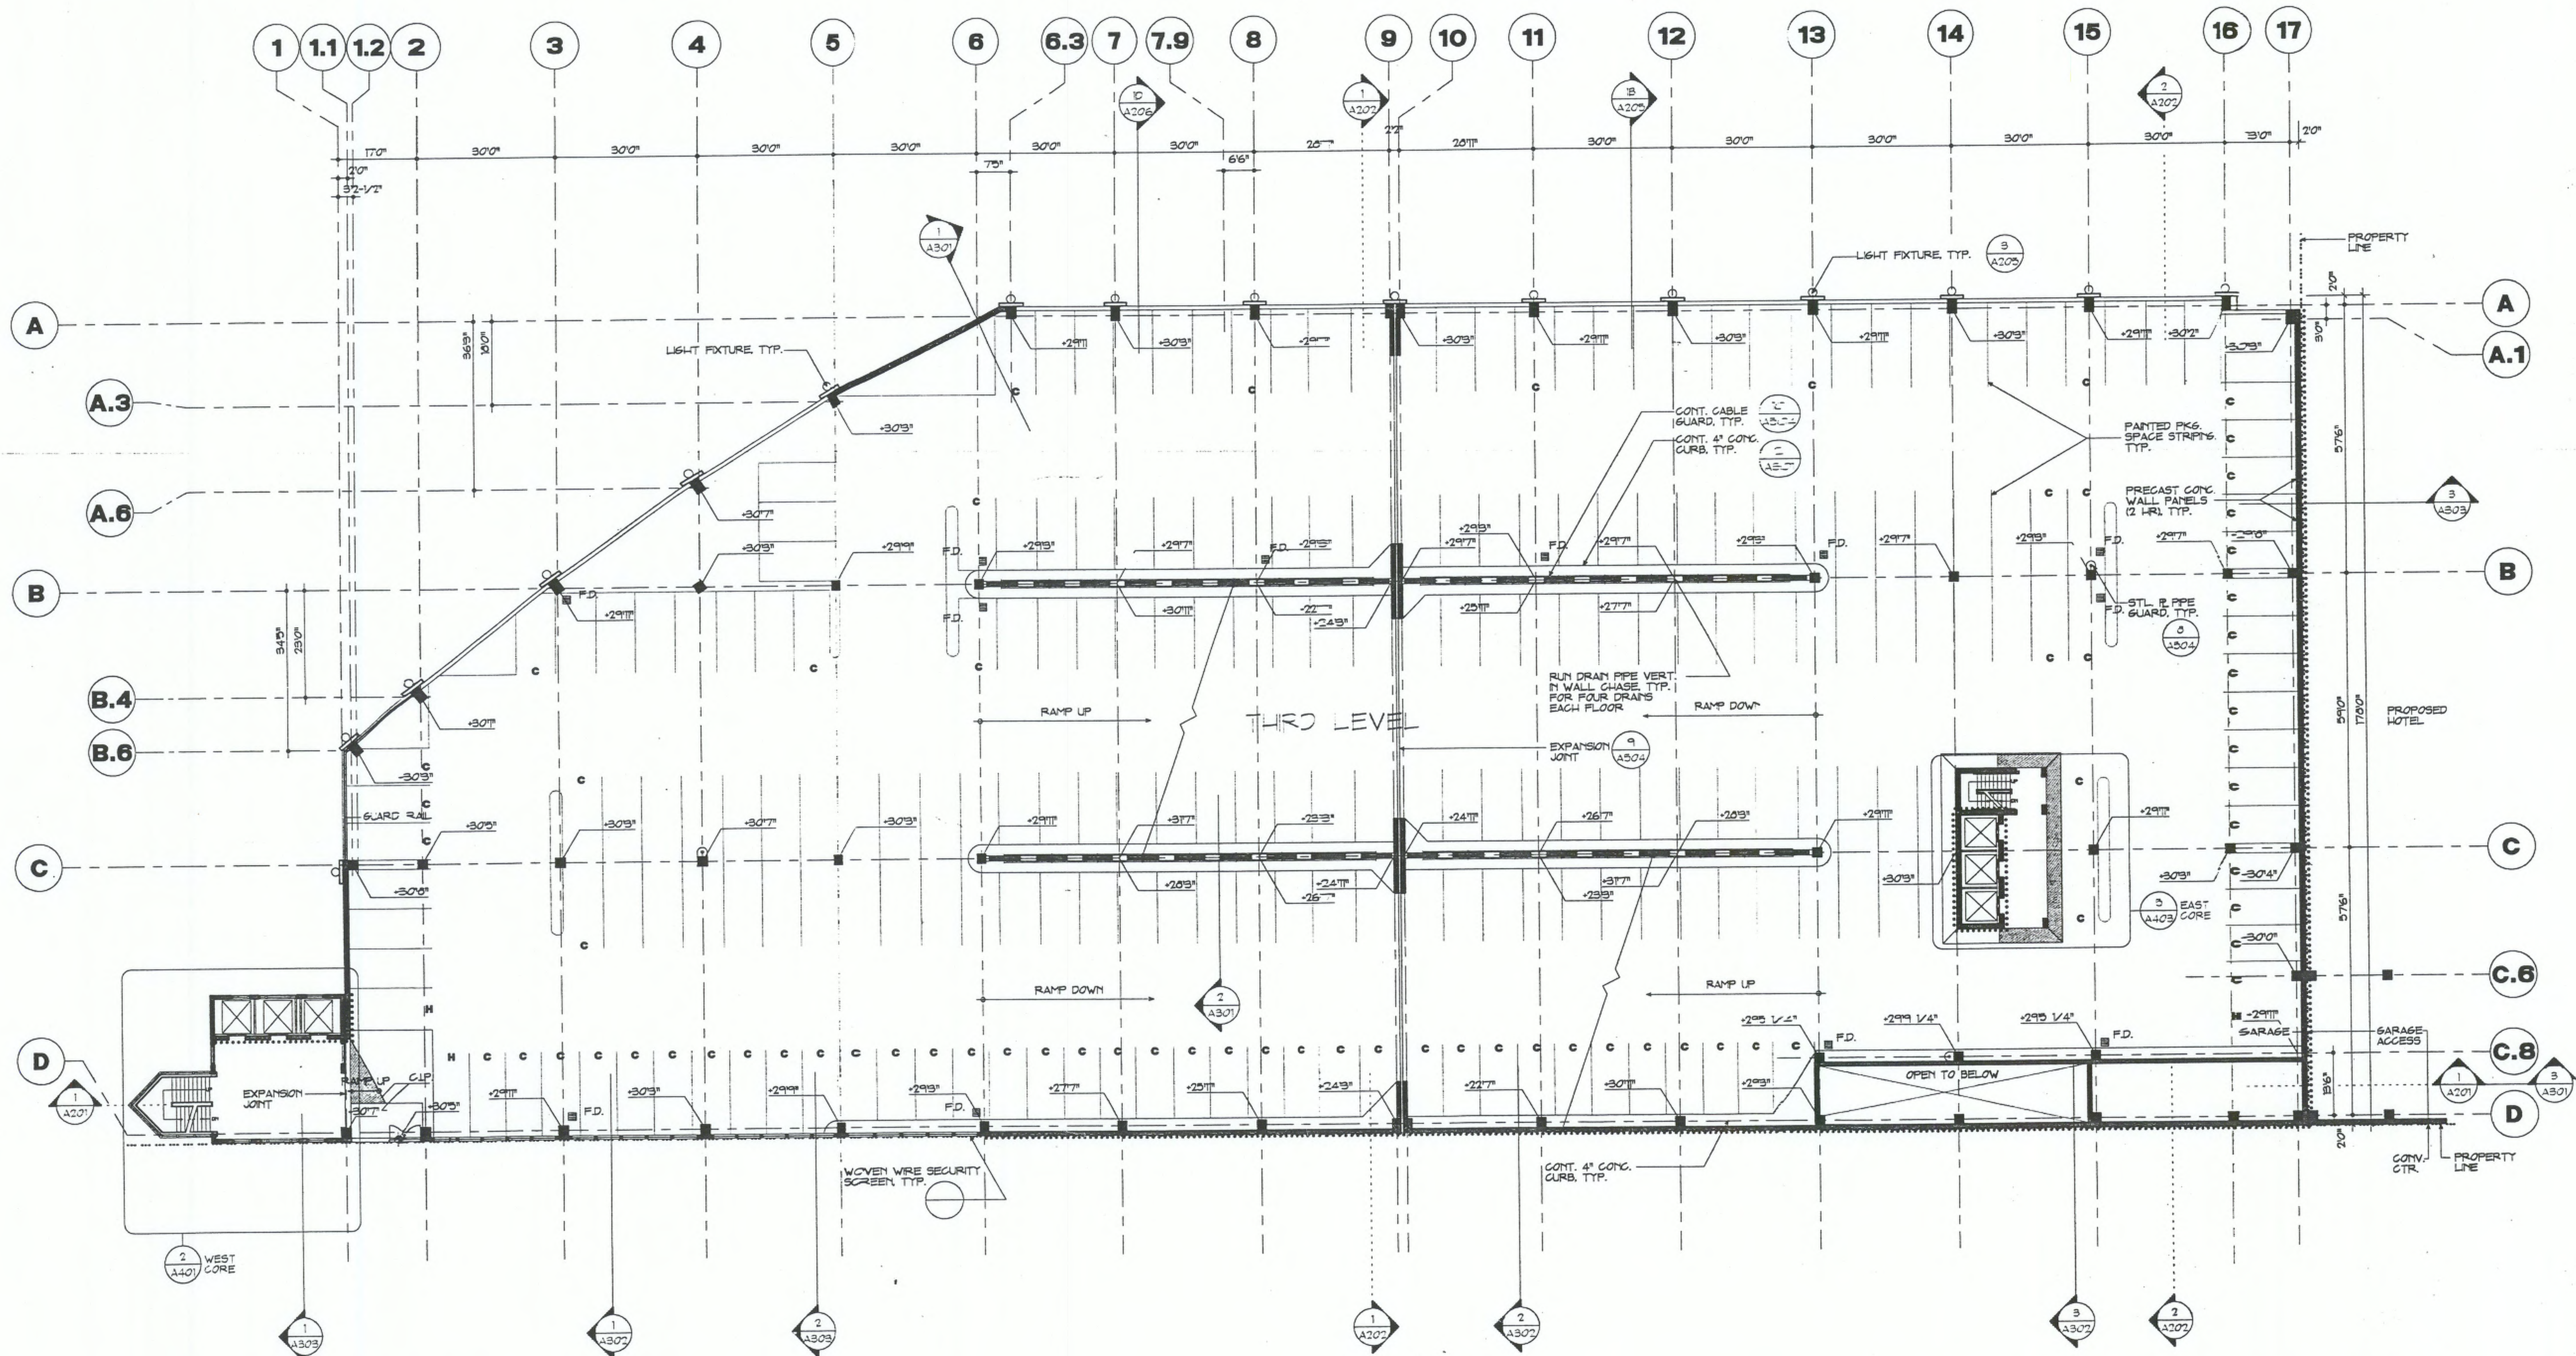


② LEVEL 3 (EL + 30)


233 PARKING SPACES

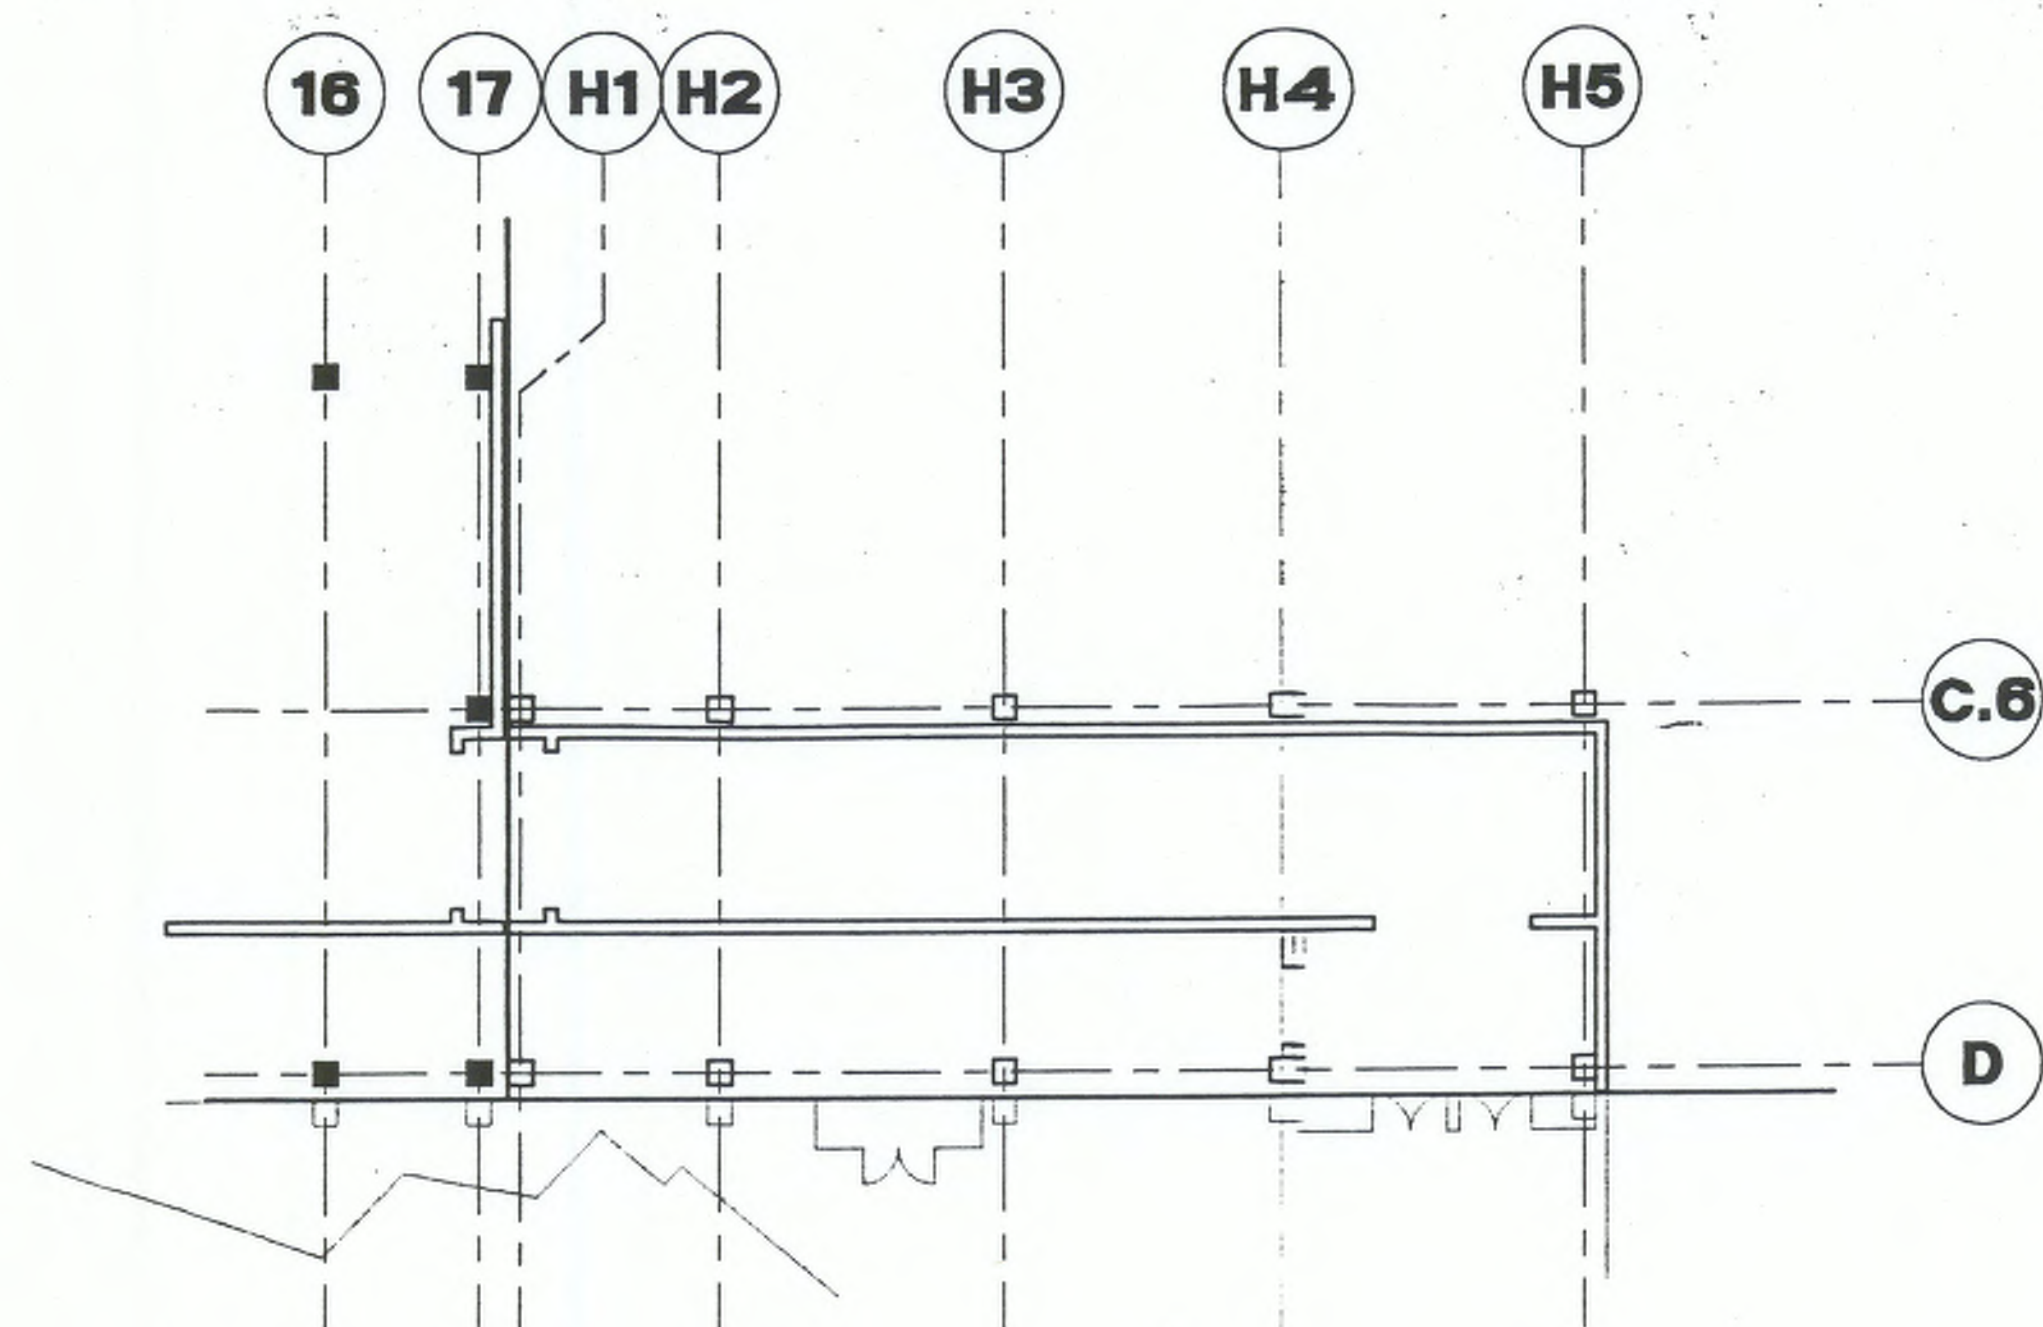

1 REFLECTED CEILING PLAN - ACCESS CORRIDOR

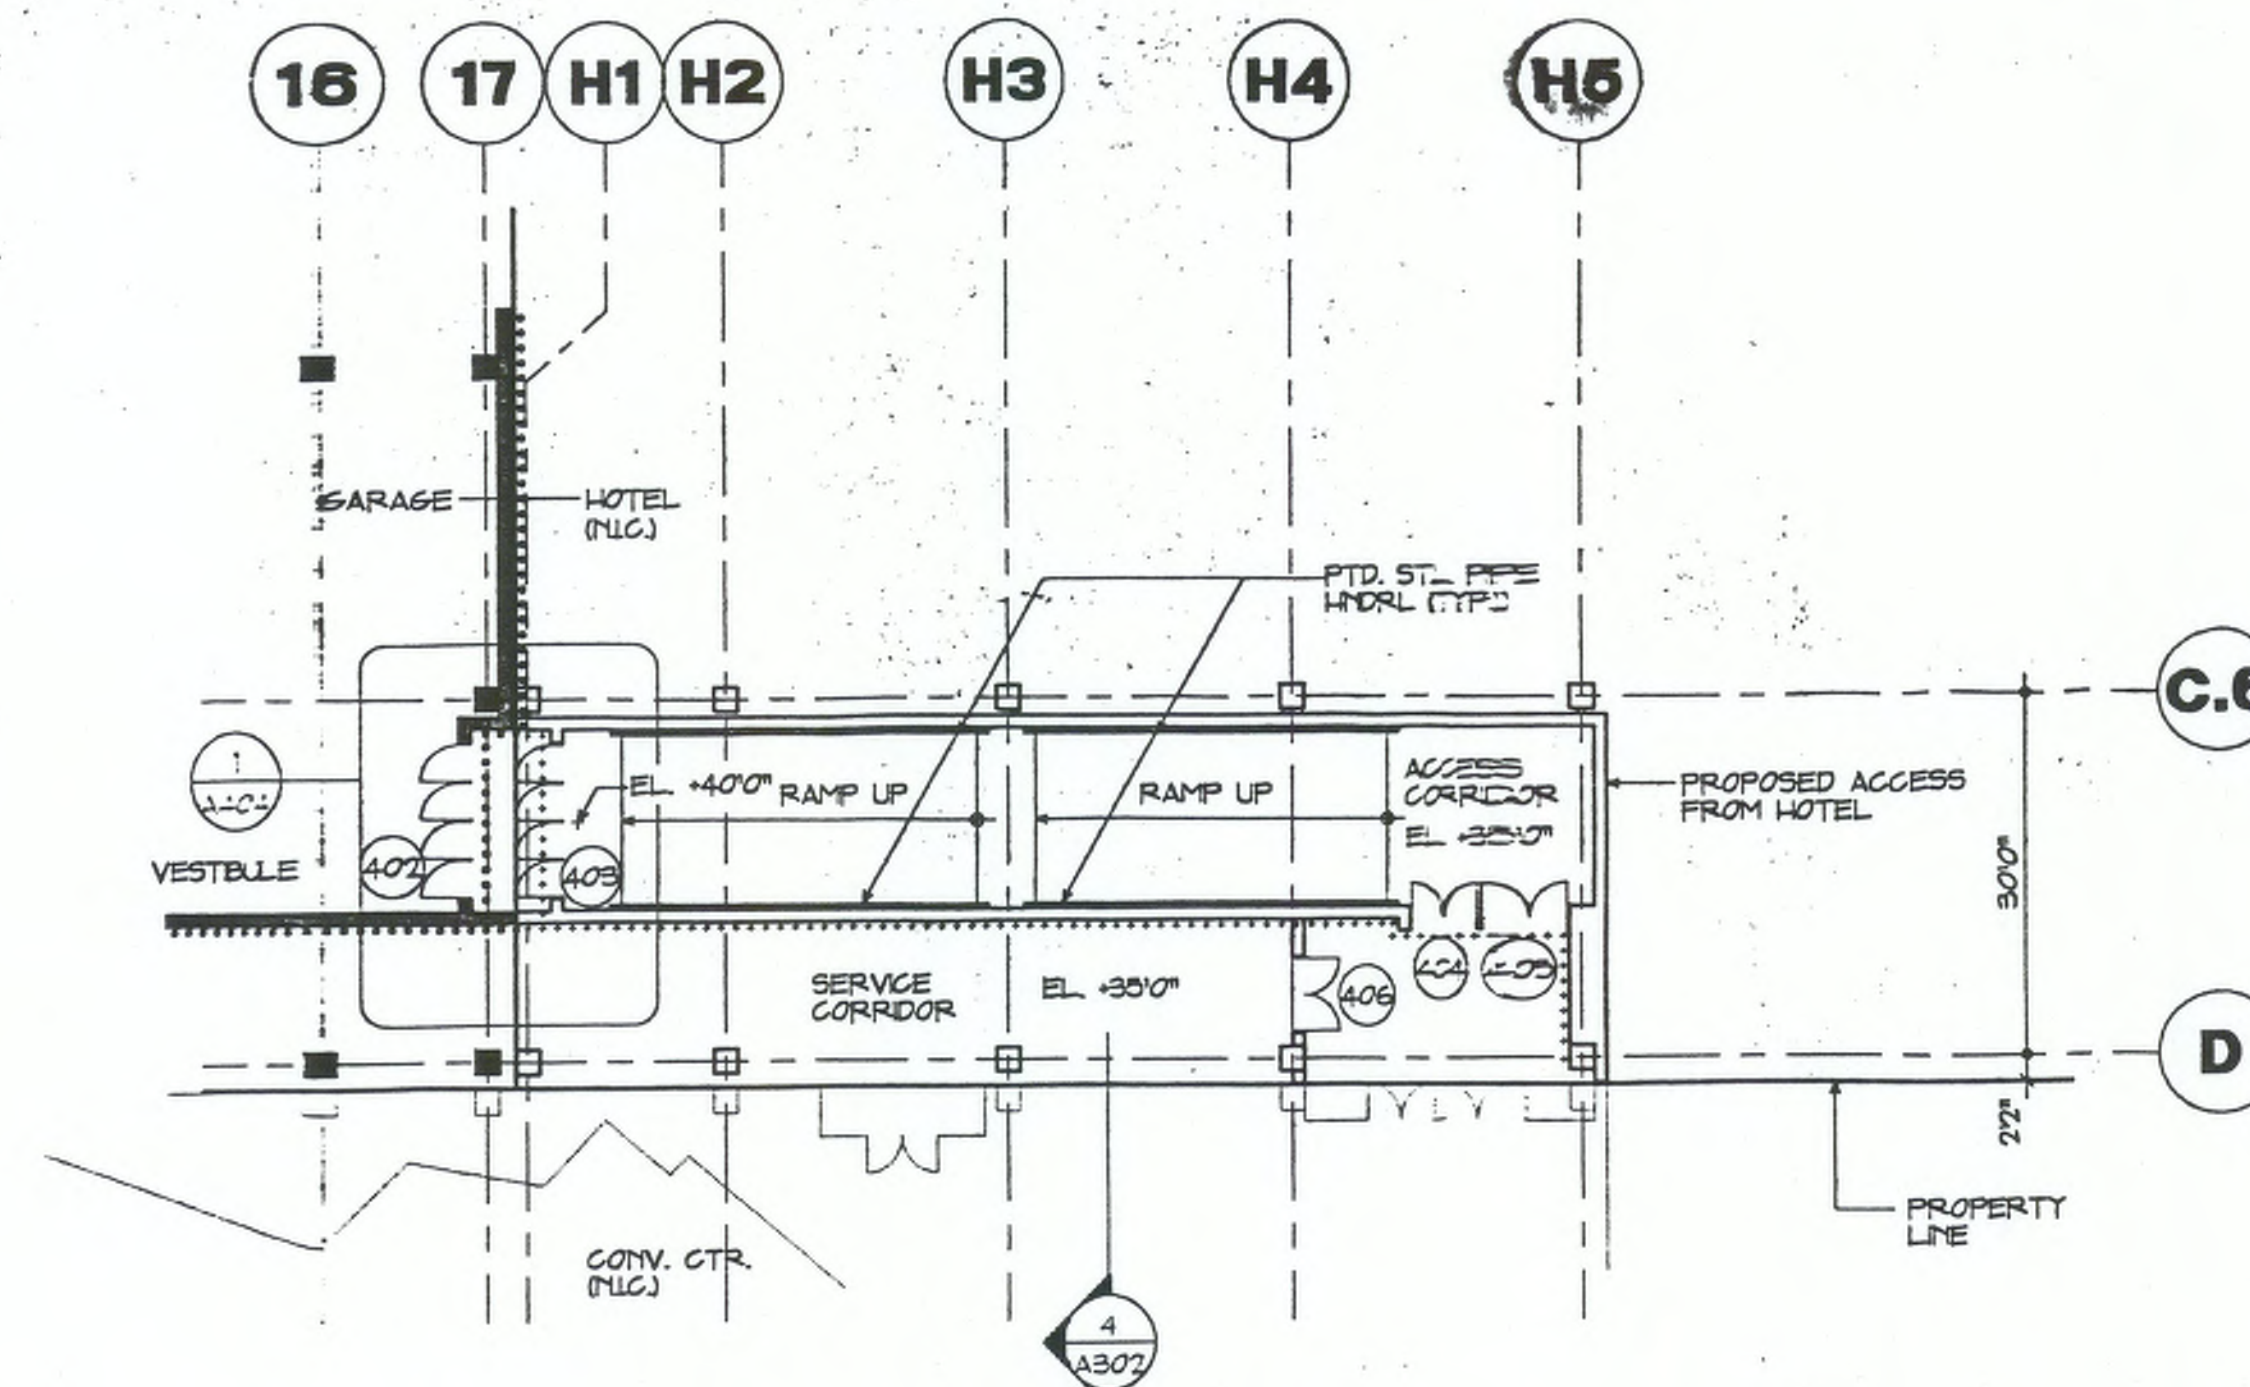

2 PART PLAN - ACCESS CORRIDOR

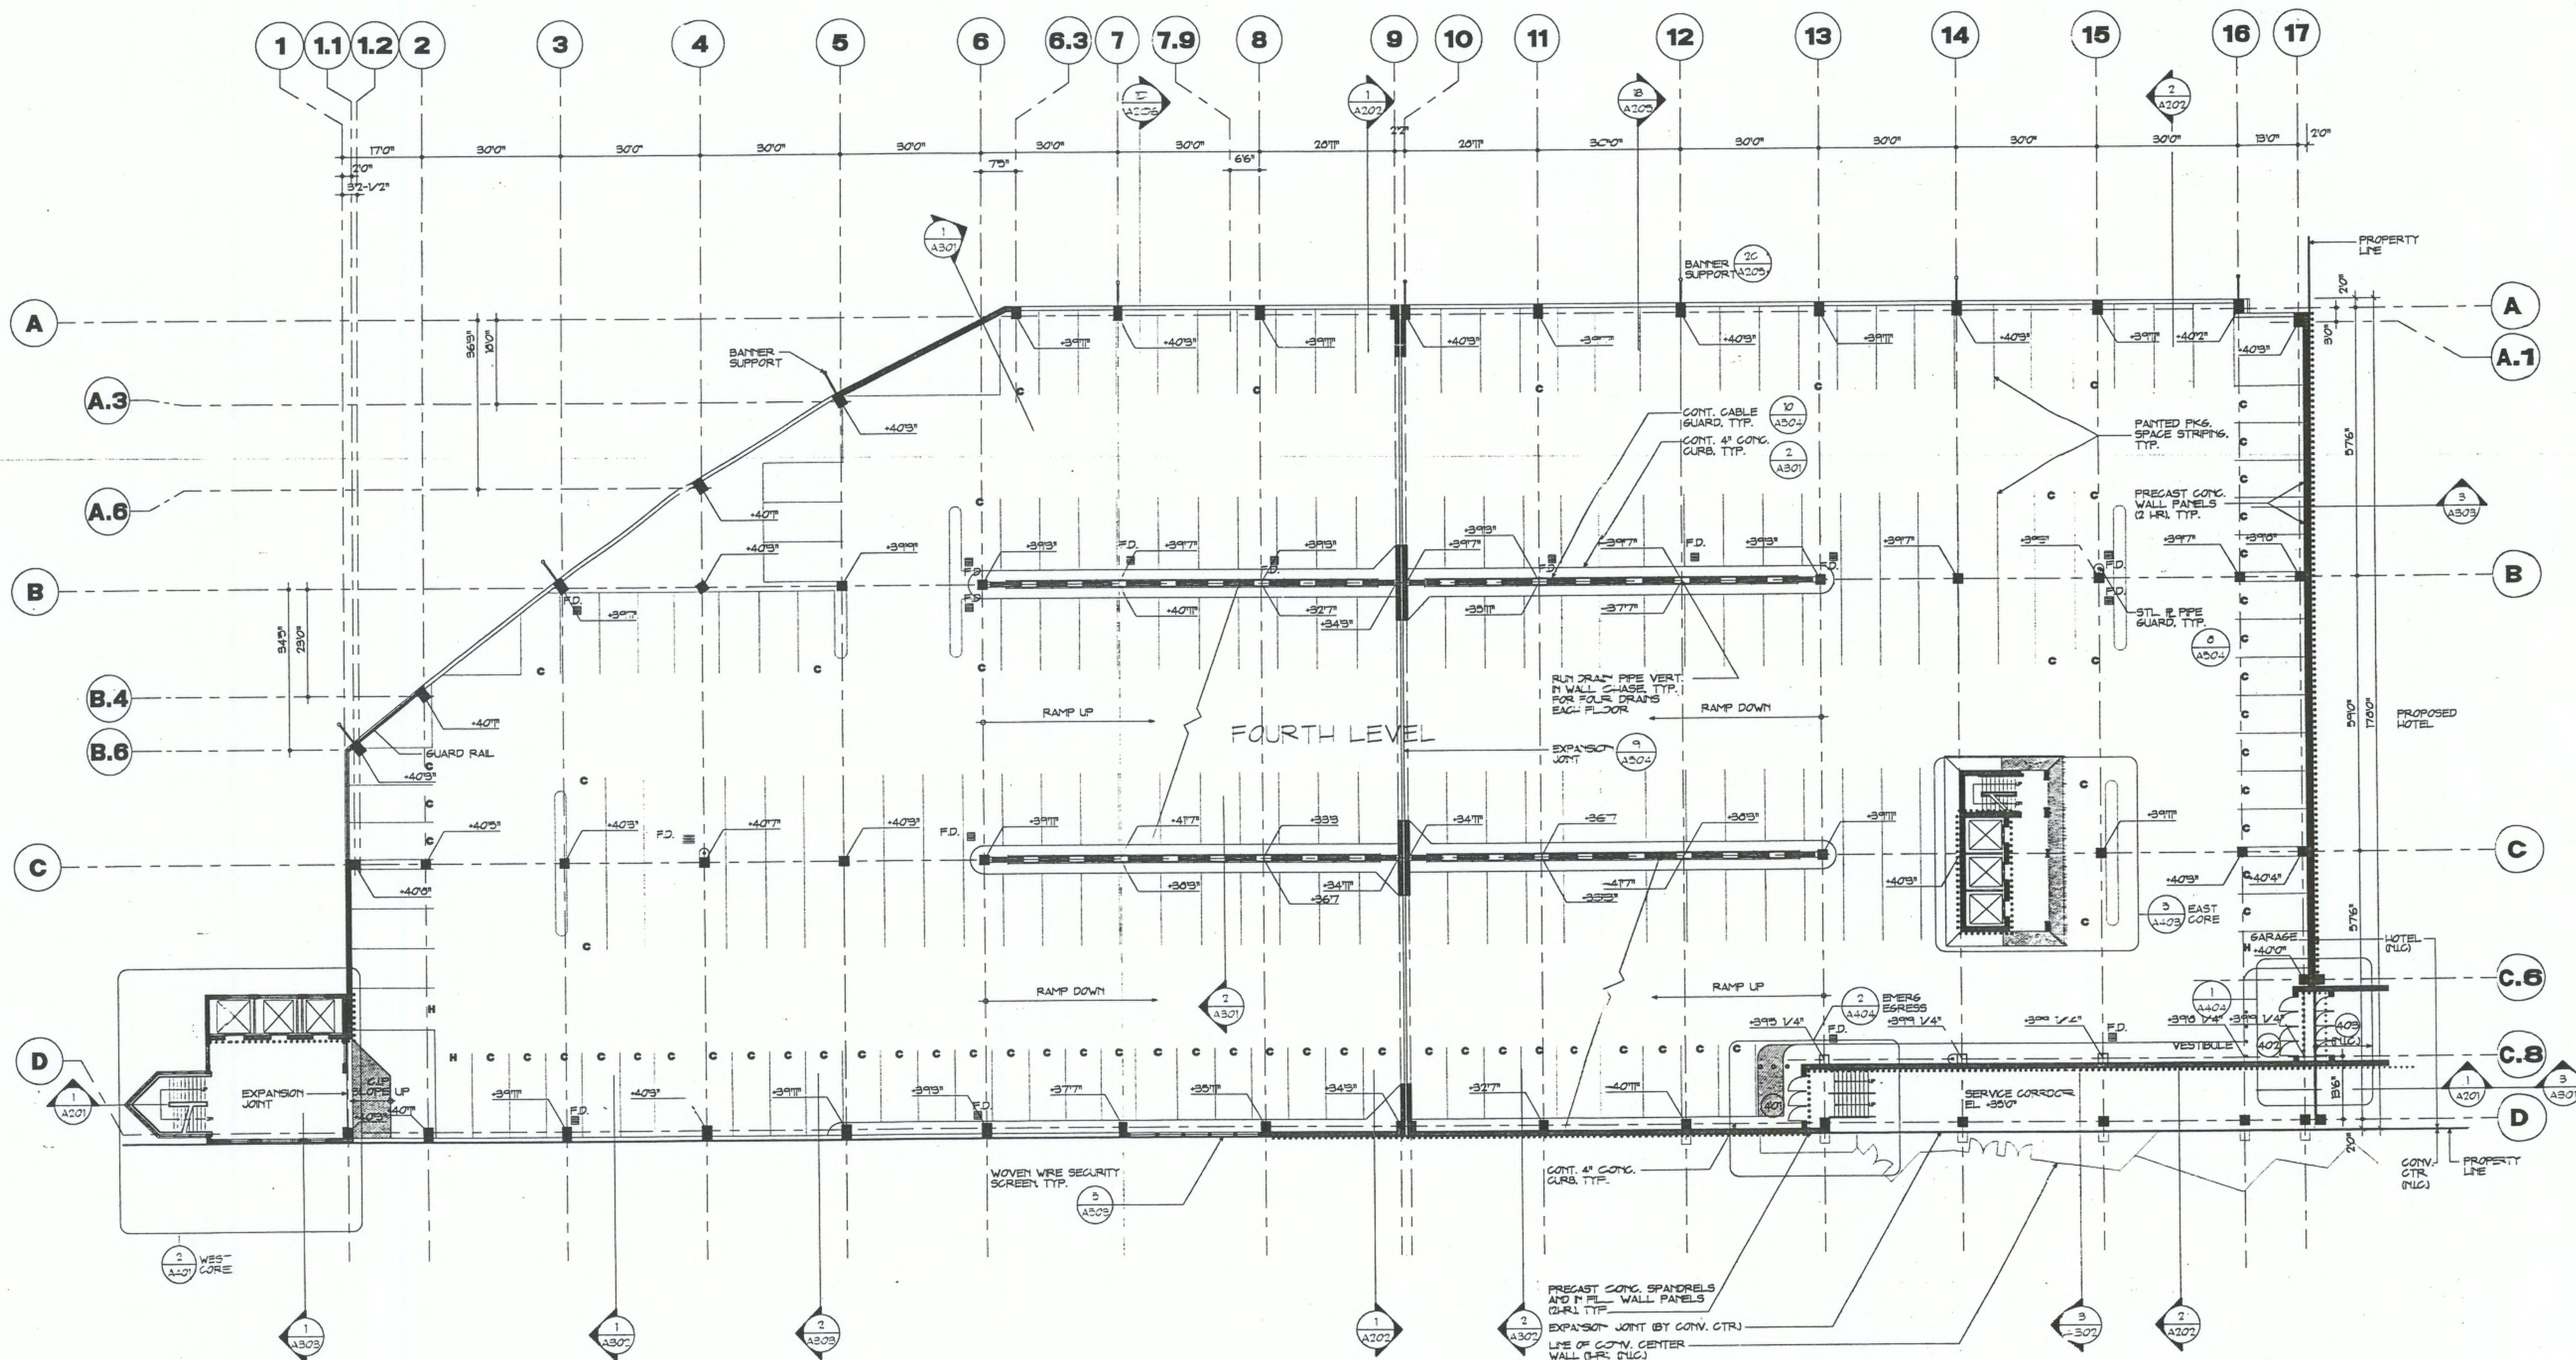

3 LEVEL 4 (EL + 40)

231 PARKING SPACES

NORTH PARKING STRUCTURE

CONVENTION CENTER
COMPLEX
PROVIDENCE
RHODE ISLAND

A METRO PARTNERS
DEVELOPMENT FOR
THE CONVENTION
CENTER AUTHORITY


CONSTRUCTION MANAGER

Marshall Contractors Inc.

75 Newman Avenue

Rumford, RI 02916

(401) 438-3500

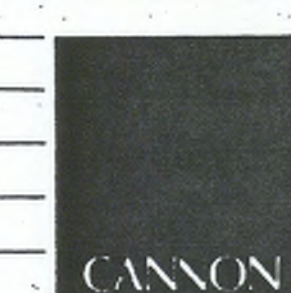

Boston

Buffalo New York

St. Louis Washington

Cannon Boston Inc.

Architects and Engineers

148 State Street

Boston, MA 02109

(617) 742-5440

Fax (617) 722-8632

Vanasse Hangen Brustlin Inc.

Civil Engineers/Surveyors

530 Broadway

Providence, RI 02909

(401) 272-8100

Desman Associates

Structural Engineers/Parking Garage Consultants

307 Fifth Avenue

New York, NY 10016

(212) 686-5360

The SWA Group


Landscape Architects

71 Boylston Street

Boston, MA 02116

(617) 266-4703

Key Plan

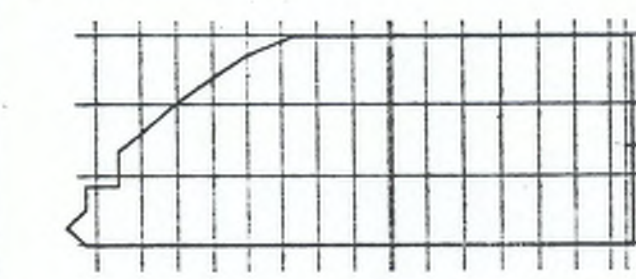

Key Plan

MAY 2, 1994 AS-BUILT

Revision Date Issued for

10 Sept. 1992 T-18-0*

Drawn by Checked by

GV JB

Project No.

9013.06

Drawing Title


FLOOR PLAN

LEVEL 4


AS BUILT

Drawing No.


A.104

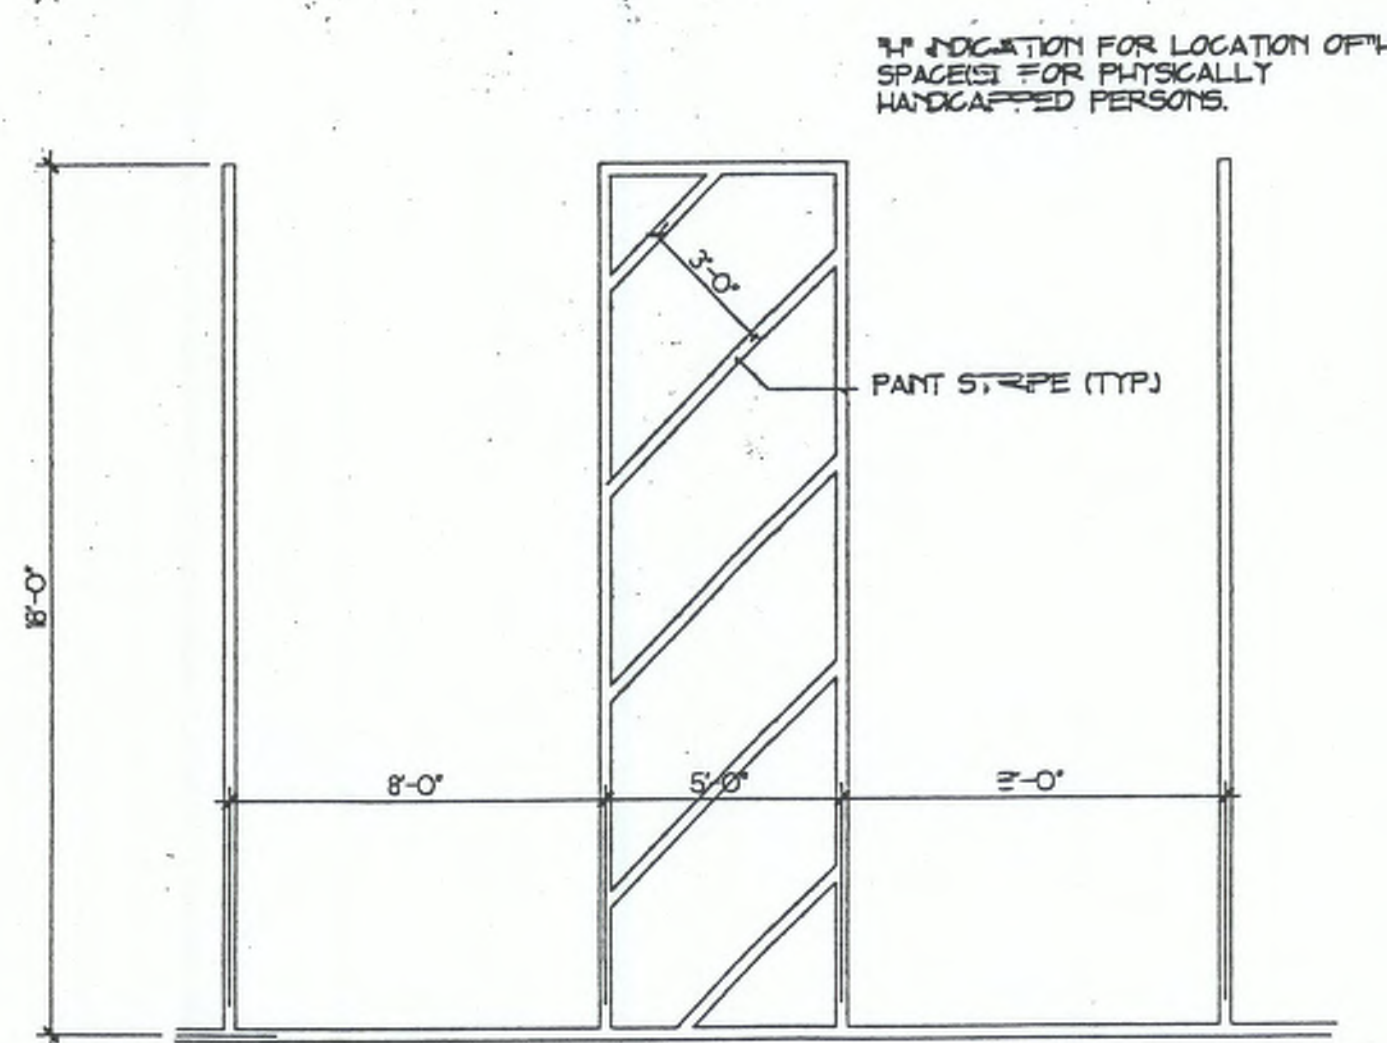


2 TYP. HANDICAPPED ACCESSIBLE SPACES.
SCALE: 1/4"=1'-0"

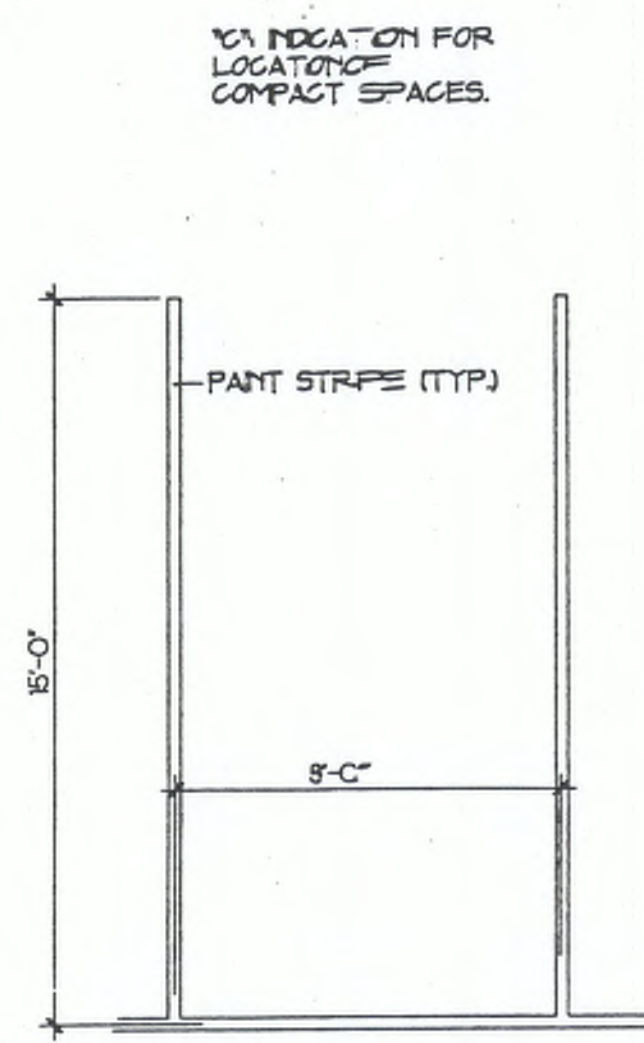


3 TYP. COMPACT SPACE.
SCALE: 1/4"=1'-0"

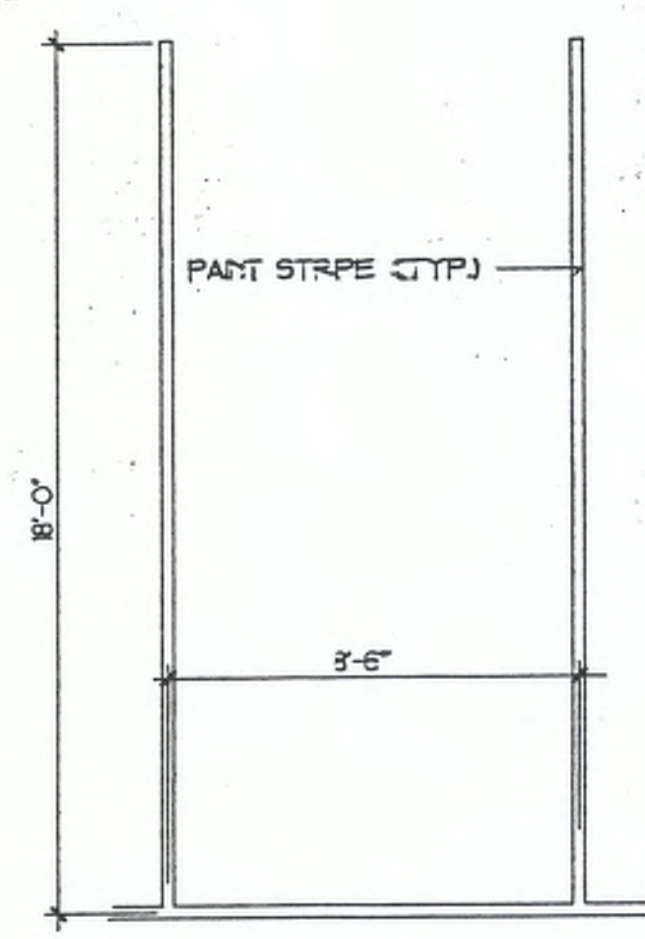

4 TYP. STANDARD SPACE.
SCALE: 1/4"=1'-0"

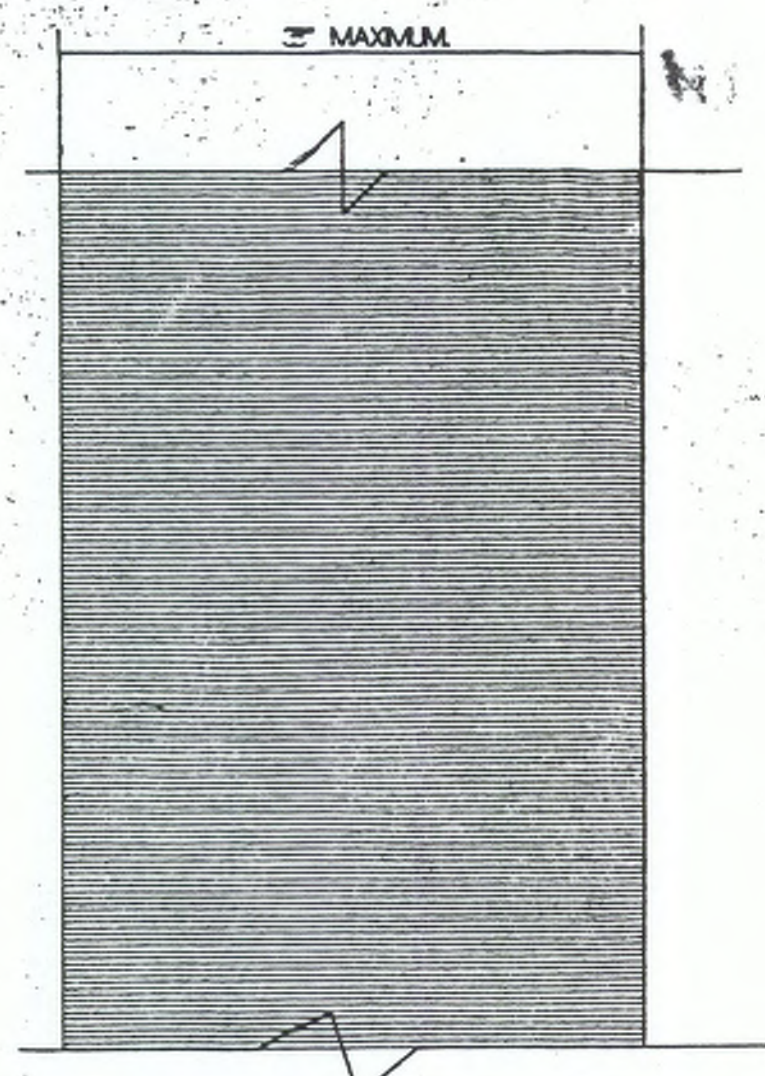

5 PAINT STRIPE
NO SCALE

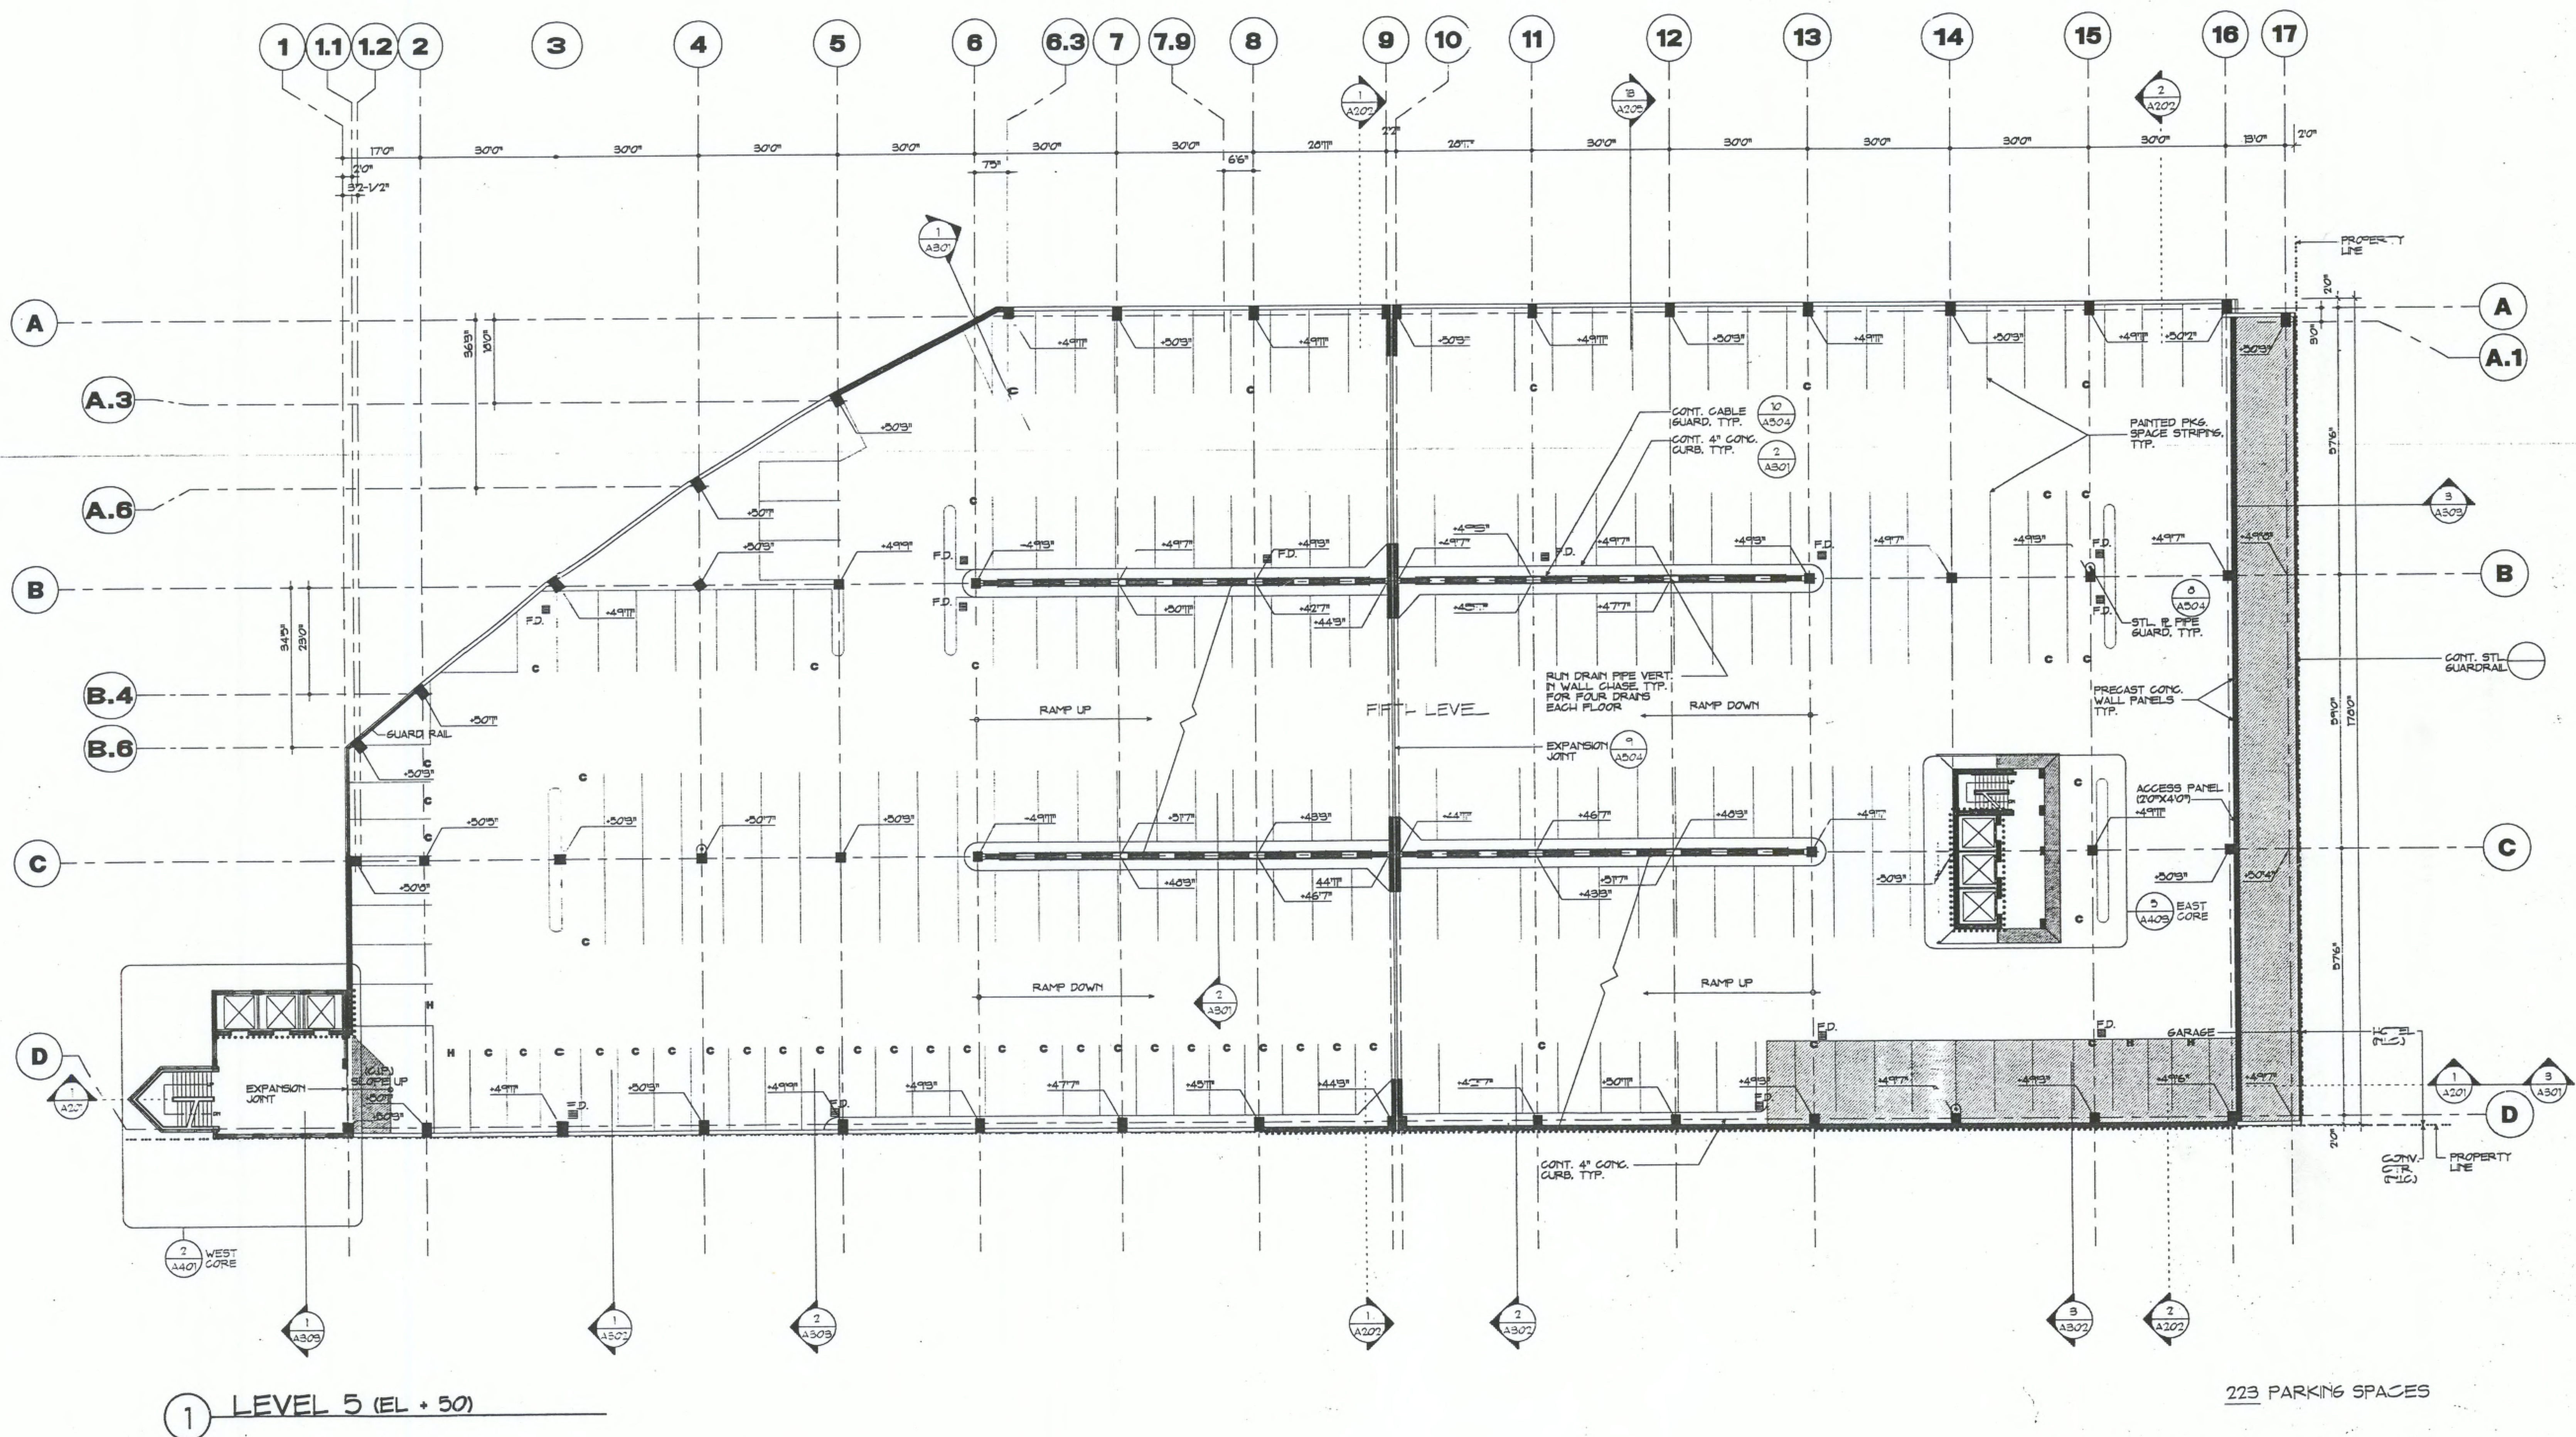

1 LEVEL 5 (EL + 50)

223 PARKING SPACES


NORTH PARKING STRUCTURE

CONVENTION CENTER
COMPLEX
PROVIDENCE
RHODE ISLAND

A METRO PARTNERS
DEVELOPMENT FOR
THE CONVENTION
CENTER AUTHORITY

CONSTRUCTION MANAGER

Marshall Contractors Inc.
75 Newman Avenue
Rumford, RI 02916
(401) 438-3500

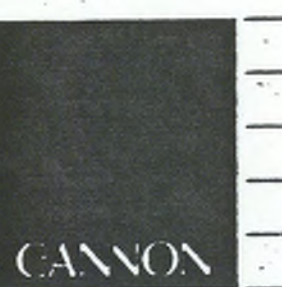


Boston
Buffalo New York
St. Louis Washington

Cannon Boston Inc.
Architects and Engineers
148 State Street
Boston, MA 02108
(617) 742-5440
Fax: (617) 723-8832

Varasse Hanger Busch Inc.
Civil Engineers/Surveyors
530 Broadway
Providence, RI 02909
(401) 272-8100

Desman Associates
Structural Engineers/Parking Garage Consultants
307 Fifth Avenue
New York, NY 10018
(212) 686-5360

The SWA Group
Landscape Architects
771 Boylston Street
Boston, MA 02116
(617) 266-4703

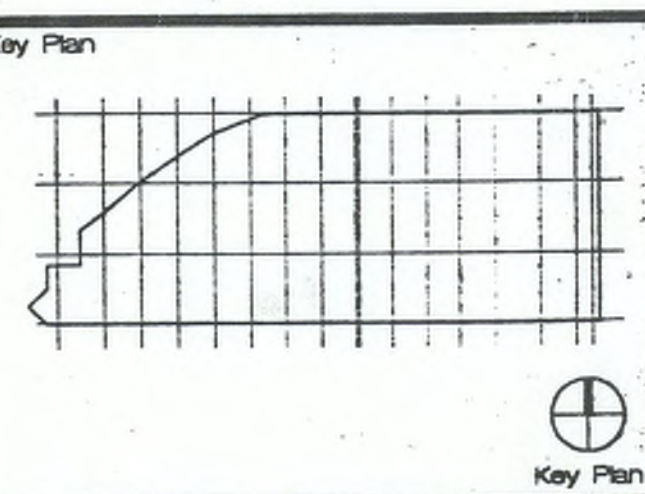

Revision	Date	Issued for
10 SEPT. 1992	1-16-0"	Scale
Drawn by	Checked by	
GV	JB	
Project No.		
90106		
Drawing Title		
FLOOR PLAN		
LEVEL 5		
AS BUILT		
Drawing No.		
A.105		

A.105

NORTH PARKING STRUCTURE

CONVENTION CENTER
COMPLEX
PROVIDENCE
RHODE ISLAND

A METRO PARTNERS
DEVELOPMENT FOR
THE CONVENTION
CENTER AUTHORITY


CONSTRUCTION MANAGER

Marshall Contractors Inc.

75 Newman Avenue

Rumford, RI 02916

(401) 438-3500

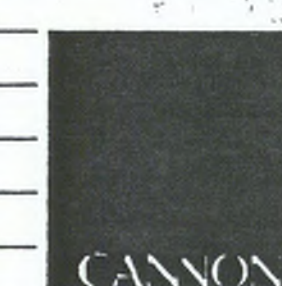

Boston

Buffalo New York

St. Louis Washington

Cannon Boston Inc.

Architects and Engineers

148 State Street

Boston, MA 02109

(617) 742-6440

Fax (617) 723-8832

Vannese Hanger Brustin Inc.

CM Engineers/Surveyors

530 Broadway

Providence, RI 02908

(401) 272-8100

Desman Associates

Structural Engineers/Parking Garage Consultants

307 Fifth Avenue

New York, NY 10016

(212) 686-5350

The SWA Group


Landscape Architects

71 Boylston Street

Boston, MA 02116

(617) 266-4703

Key Plan

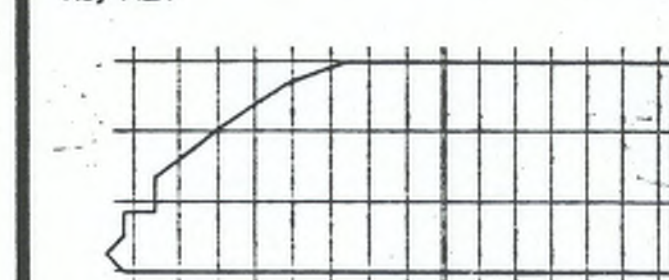

Key Plan

MAY 20

MAY 2, 1994 AS-BUILT

Revision Date Issued for

Date Scale

10 SEPT. 1992 1"=15'-0"

Drawn by Checked by

GV JB/GV

Project No.

90106

Drawing Title


FLOOR PLAN

LEVEL 6

AS BUILT

Drawing No.

A.106

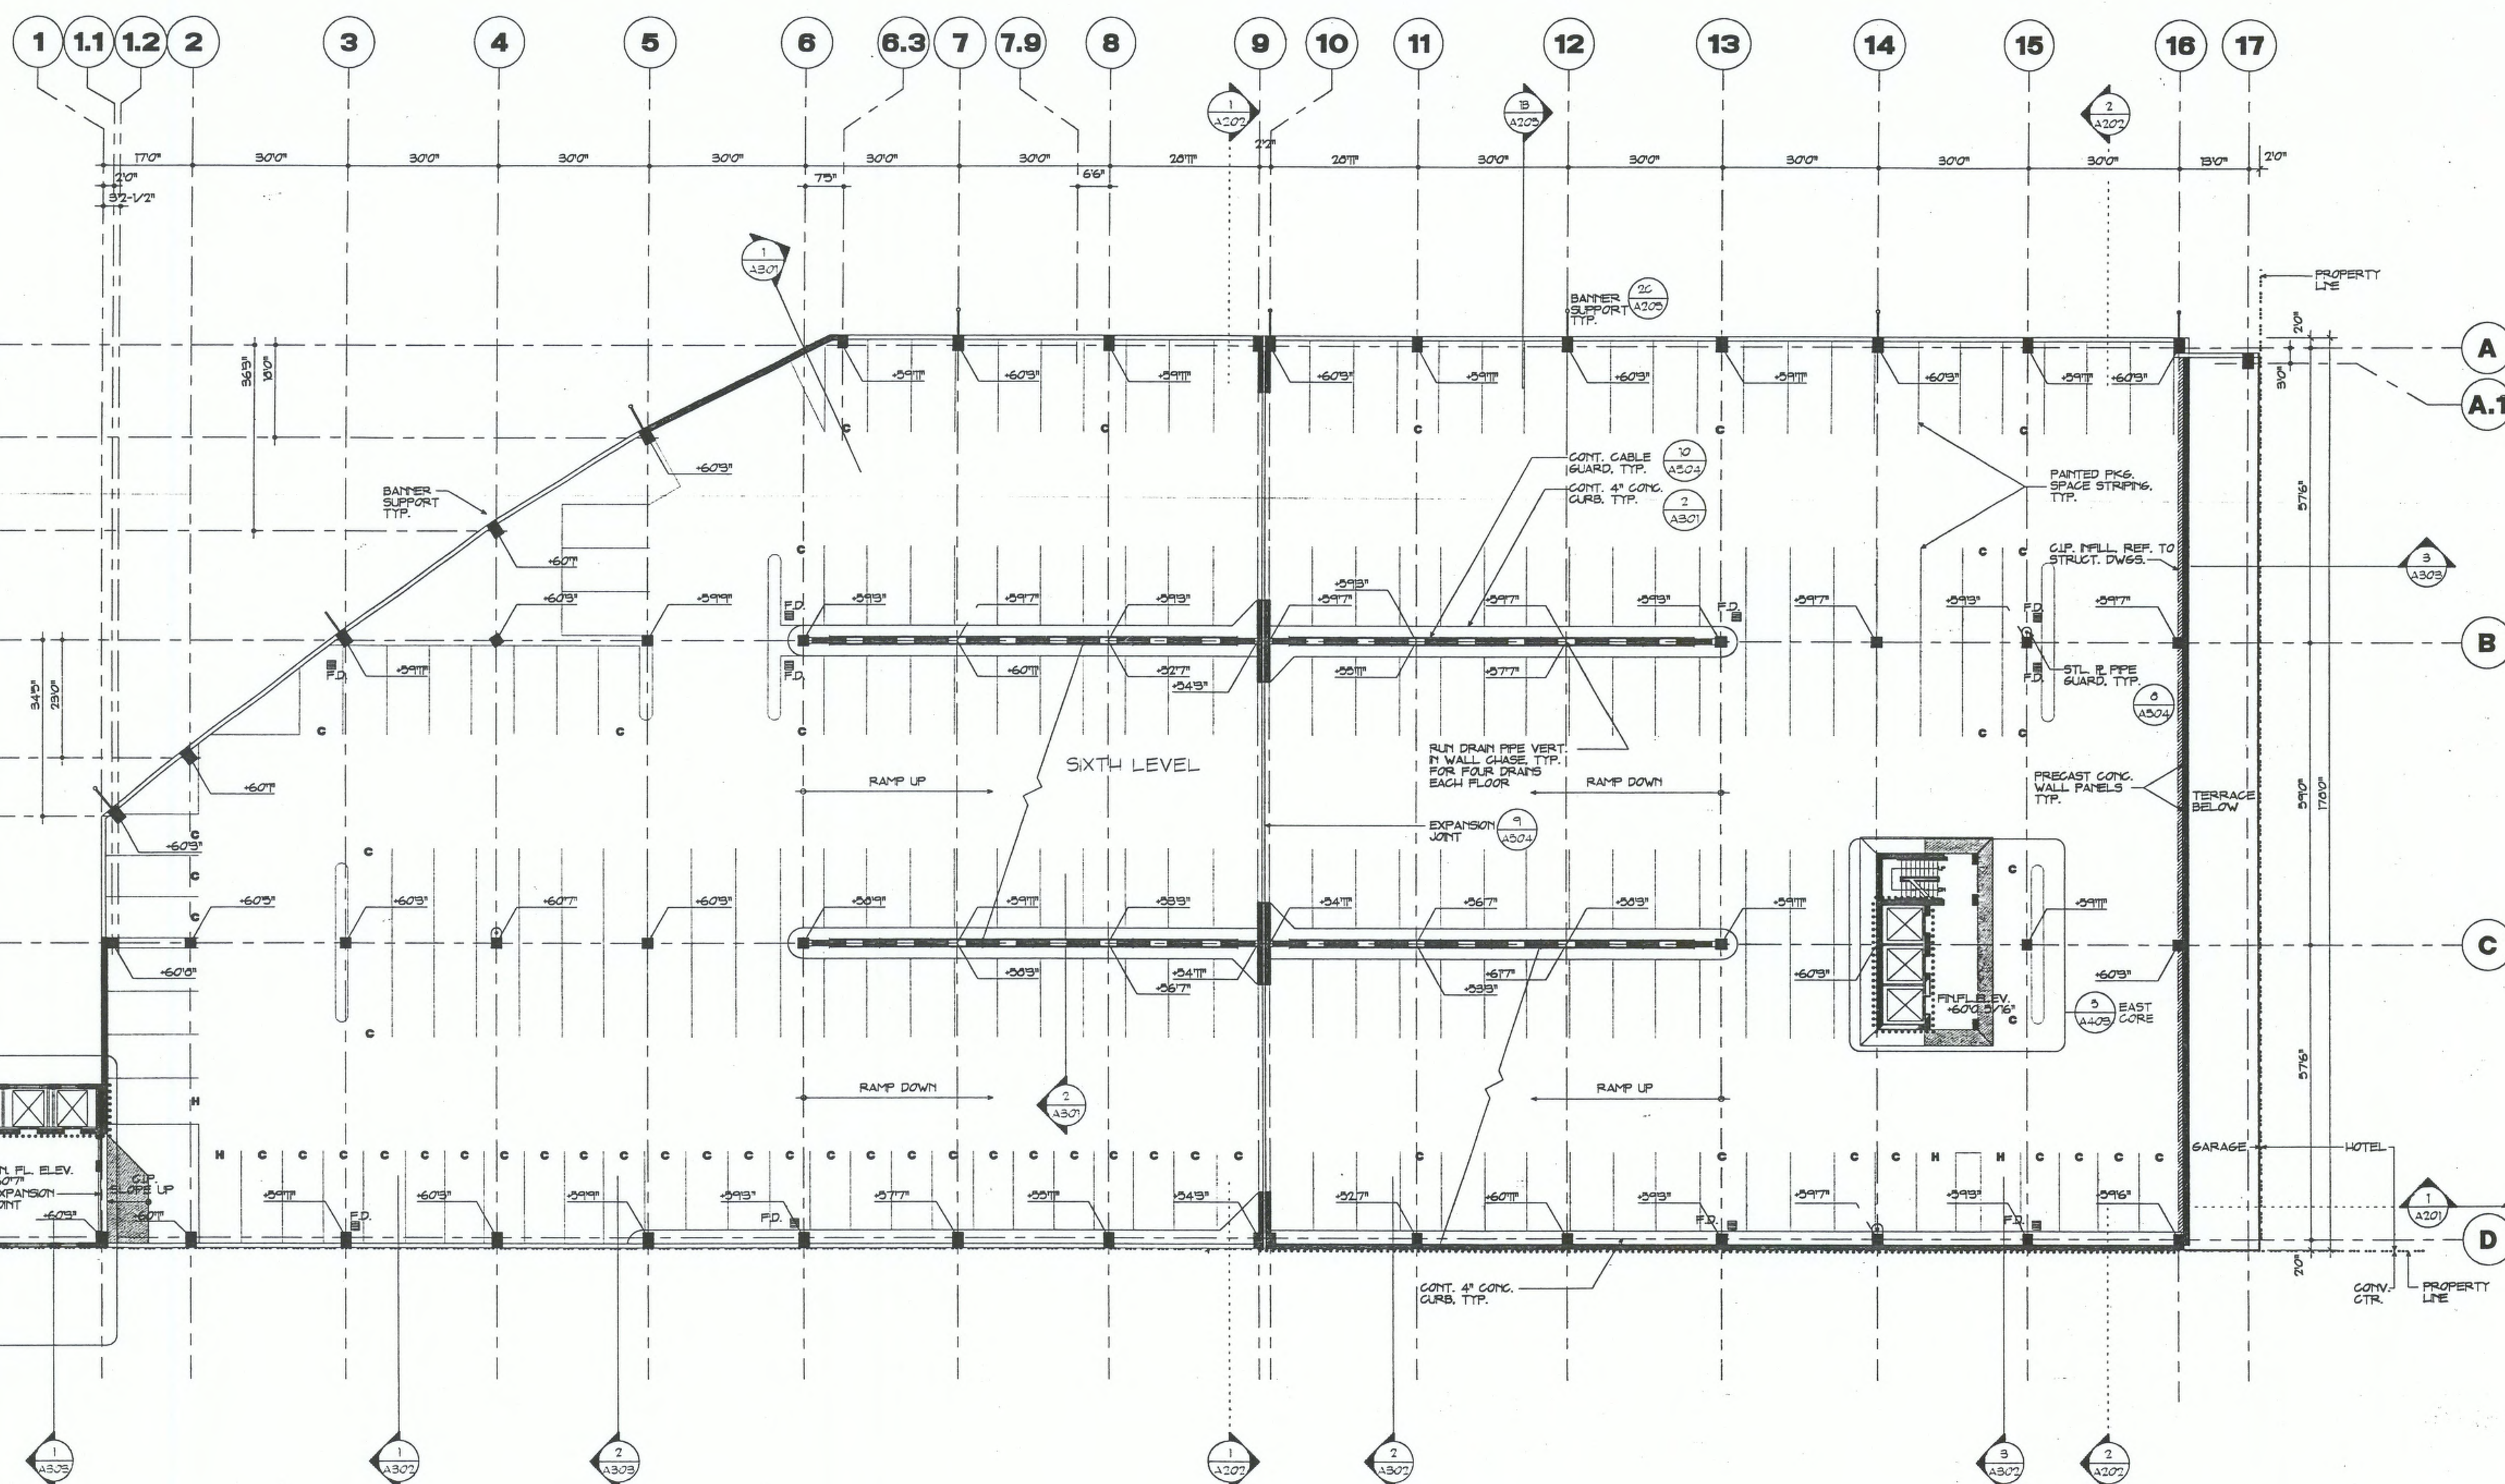

1 LEVEL 6 (EL + 60)

227 PARKING SPACES

PGA106.VWF


NORTH PARKING STRUCTURE

CONVENTION CENTER
COMPLEX
PROVIDENCE
RHODE ISLAND

A METRO PARTNERS
DEVELOPMENT FOR
THE CONVENTION
CENTER AUTHORITY

CONSTRUCTION MANAGER

Marshall Contractors Inc.
75 Newman Avenue
Rumford, RI 02916
401 438-3500

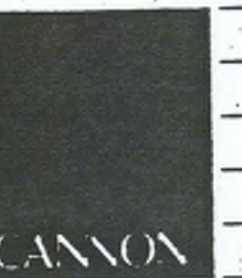

Boston
Buffalo New York
St. Louis Washington


Cannon Boston Inc.
Architects and Engineers
148 State Street
Boston, MA 02109
617 742-5440
Fax 617 722-8833

Vanasse Hangen Brustlin Inc.
Civil Engineers/Surveyors
530 Broadway
Providence, RI 02909
401 272-8000

Desman Associates
Structural Engineers/Parking Garage Consultants
307 Fifth Avenue
New York, NY 10018
212 688-5360

The SWA Group
Landscape Architects
71 Boylston Street
Boston, MA 02116
617 266-4703

Key Plan

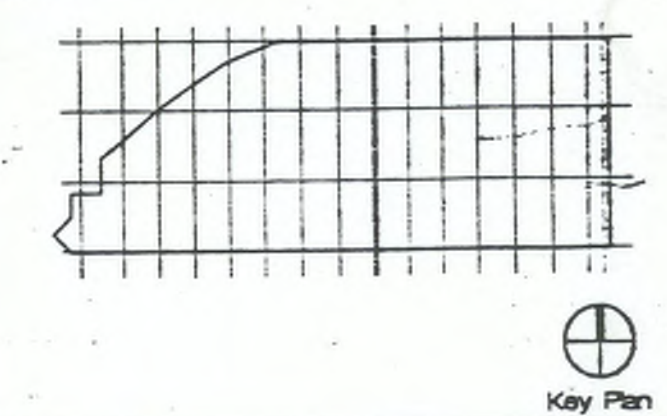

Key Plan

MAY 2 1994 AS-BUILT

Revision Date Issued for

Date Scale

10 SEPT. 1992 1"=16'-0"

Drawn by Checked by

GV JB/GV

Project No.

903.06

Drawing Title


FLOOR PLAN

LEVEL 7

AS BUILT

Drawing No.

A.107

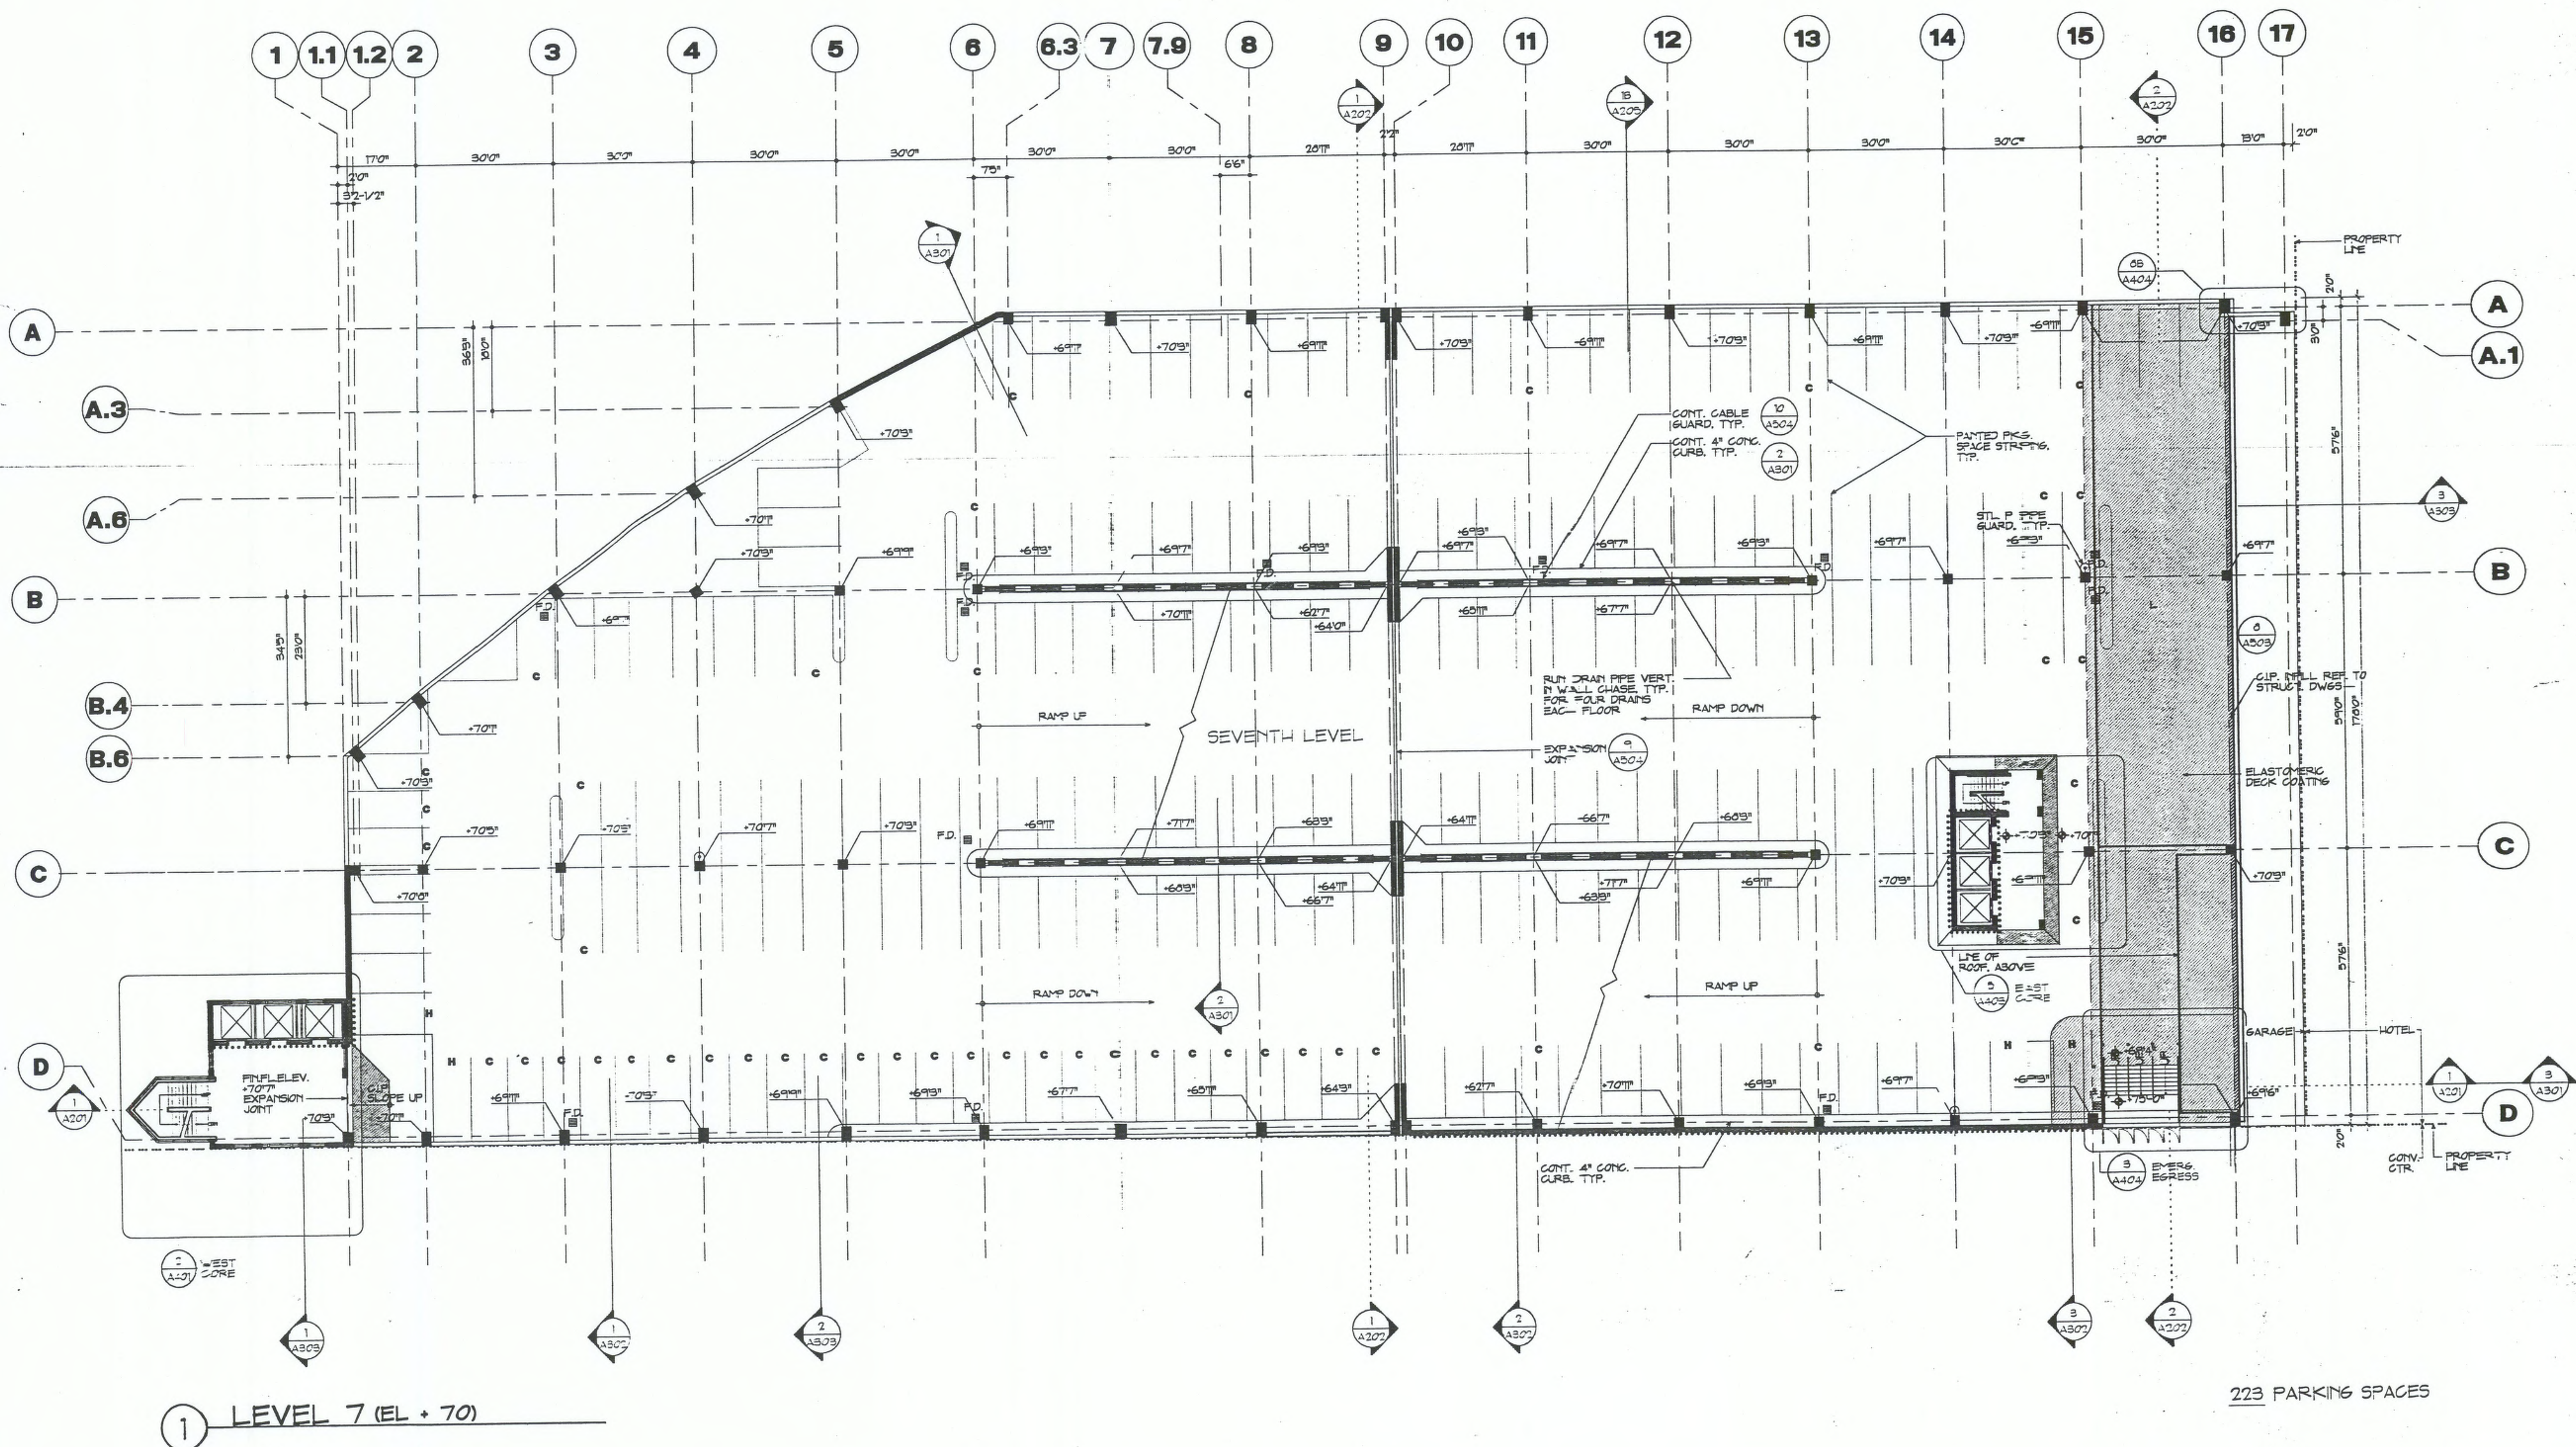

223 PARKING SPACES

NORTH PARKING STRUCTURE

CONVENTION CENTER
COMPLEX
PROVIDENCE
RHODE ISLAND

A METRO PARTNERS
DEVELOPMENT FOR
THE CONVENTION
CENTER AUTHORITY

CONSTRUCTION MANAGER

Marshall Contractors Inc.

75 Newman Avenue

Rumford, RI 02918

401 438-3500



Boston

Buffalo New York

St. Louis Washington

Cannon Boston Inc.

Architects and Engineers

14 State Street

Boston, MA 02109

617 742-5440

Fax 617 723-8832

Vannese Hangan Brustin Inc.

Civil Engineers/Surveyors

530 Broadway

Providence, RI 02909

401 272-8000

Desman Associates

Structural Engineers/Parking Garage Consultants

307 Fifth Avenue

New York, NY 10016

212 686-5360

The SWA Group

Landscape Architects

71 Boylston Street

Boston, MA 02116

617 266-4703

Key Plan



Key Plan

REV 2.0

MAY 2, 1994 AS-BUILT

Revision Date Issued for

Date Scale

10 SEPT. 1992 1"=16'-0"

Drawn by Checked by

GV JB/GV

Project No.

9003.06

Drawing Title

FLOOR PLAN

LEVEL 8

AS BUILT

Drawing No.

A.108

1 ROOF PLAN - WEST CORE

SCALE: 1/8" = 1'-0"

2 PART PLAN @ CROSSOVER (ALTERNATE)

50 PARKING SPACES

3 ROOF PLAN - EAST CORE

SCALE: 1/8" = 1'-0"

4 LEVEL 8 (EL + 80)

200 PARKING SPACES


GENERAL NOTES:

1 ENTIRE EXT. DECK SURFACE


FINISH TO HAVE ELASTOMERIC

DECK COATING.

PGA108.VWF

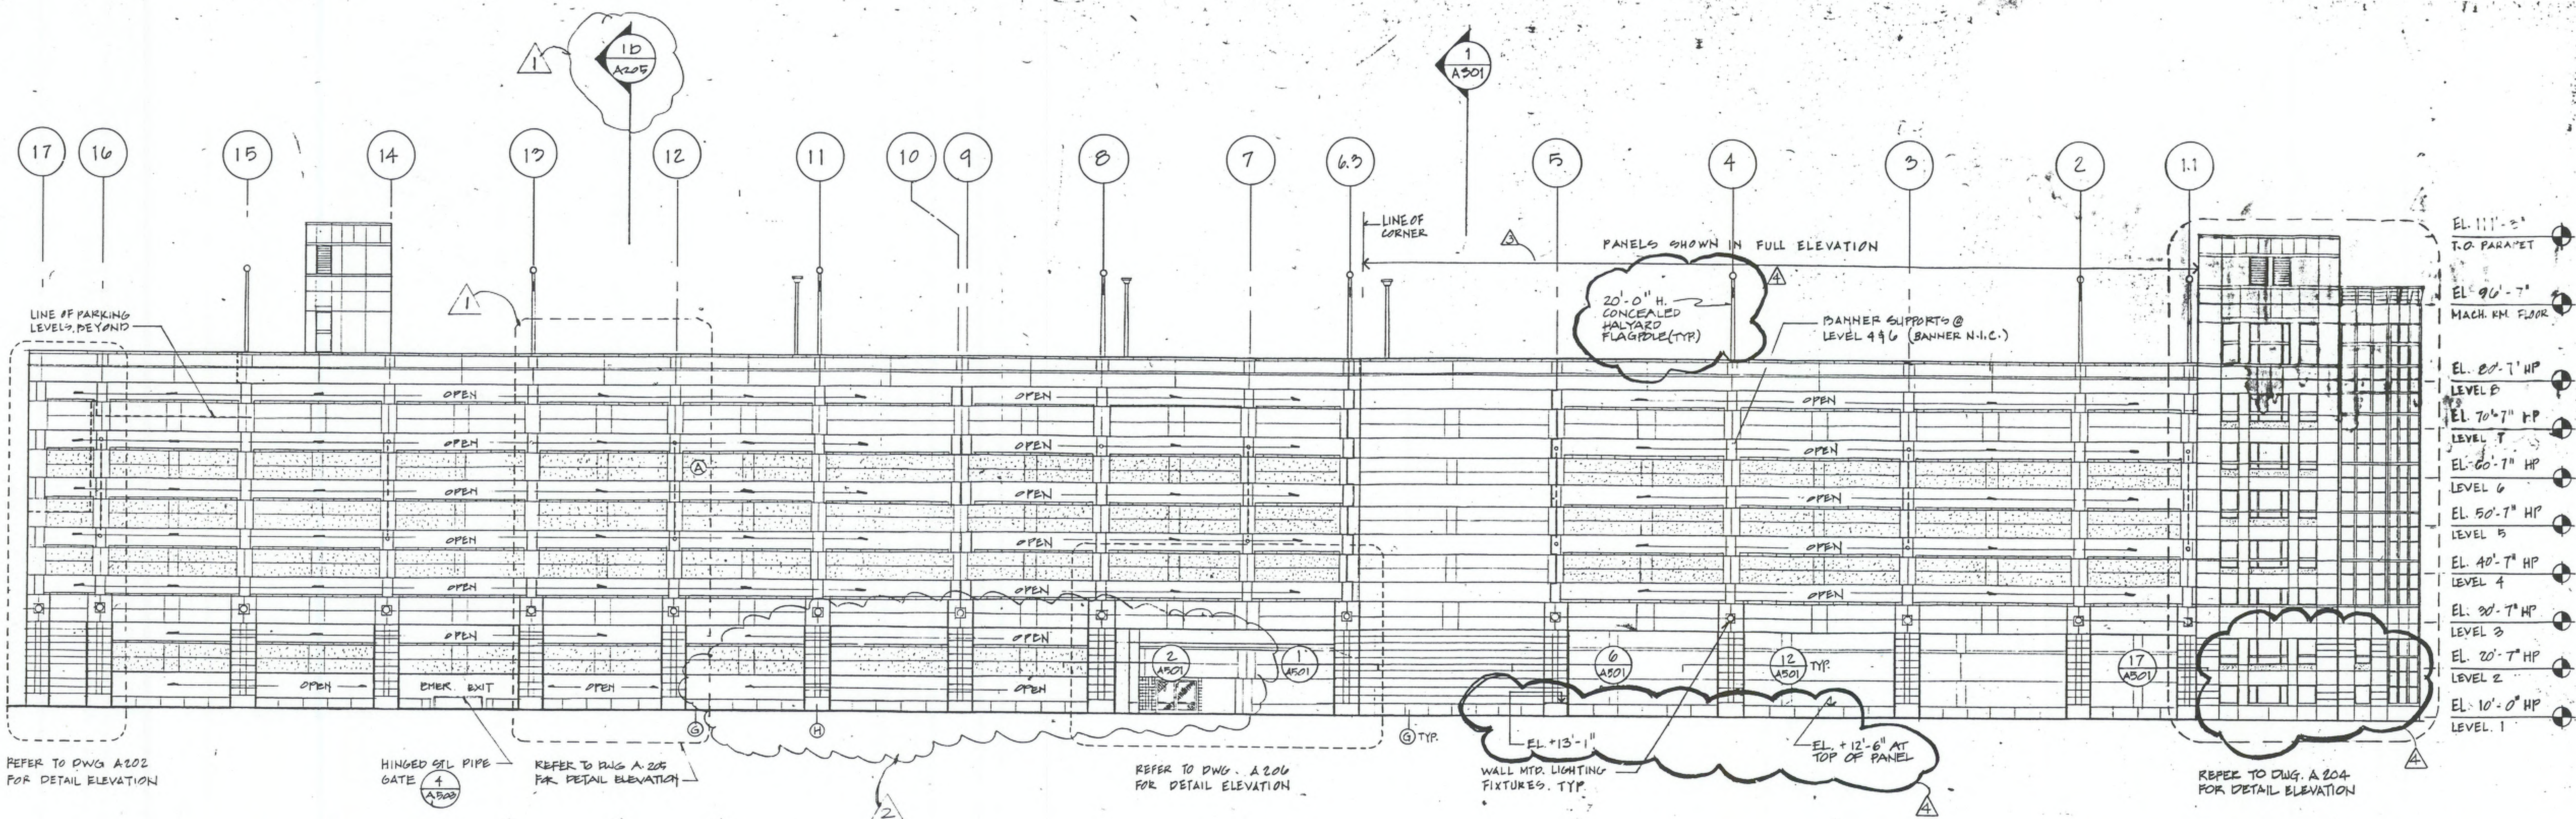

1 NORTH ELEVATION
SCALE: 1/16" = 1'-0"

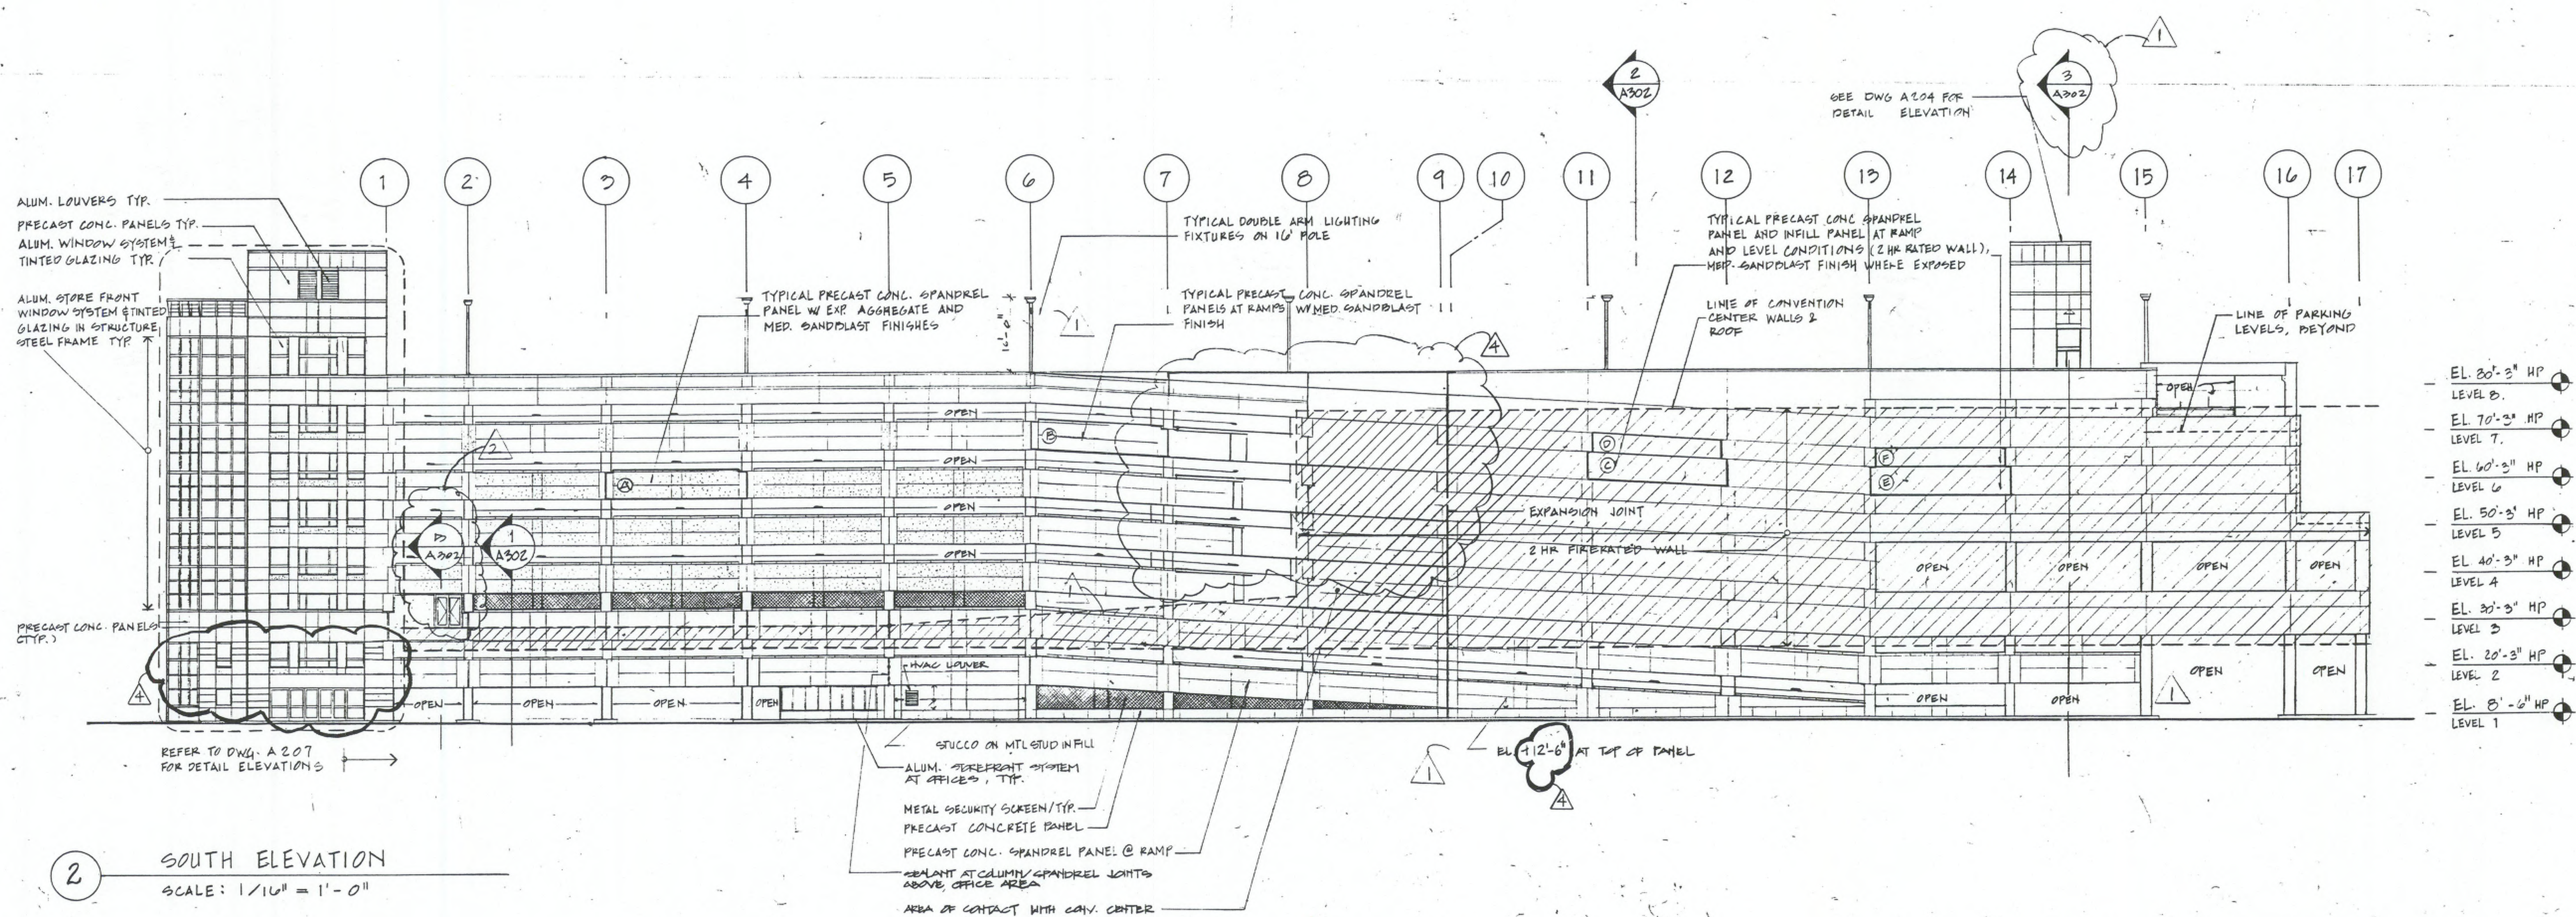

2 SOUTH ELEVATION
SCALE: 1/16" = 1'-0"

NORTH PARKING STRUCTURE

CONVENTION CENTER
COMPLEX
PROVIDENCE
RHODE ISLAND

A METRO PARTNERS
DEVELOPMENT FOR
THE CONVENTION
CENTER AUTHORITY

CONSTRUCTION MANAGER

Marshall Contractors Inc.
75 Newman Avenue
Rumford, RI 02916
401 438-3500

CANNON


Boston
Buffalo New York
St. Louis Washington

Cannon Boston Inc.
Architects and Engineers
148 State Street
Boston, MA 02109
617 742-5440
Fax 617 723-8832

Vanasse Hangen Brustlin Inc.
Civil Engineers/Surveyors
530 Broadway
Providence, RI 02909
401 272-8100

Desman Associates
Structural Engineers/Parking Garage Consultants
307 Fifth Avenue
New York, NY 10016
212 696-6350


The SWA Group
Landscape Architects
71 Bay State Street
Boston, MA 02116
617 266-4703

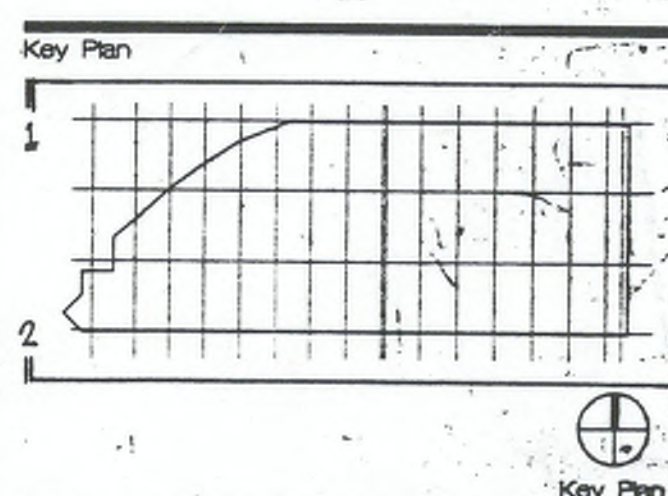

MAY 2, 1994 AS-BUILT
9 NOV 92
5 JUNE 91 BULLETIN # 5
14 FEB 91 BULLETIN # 1
5 FEB 91 BULLETIN # 1
Revision Date Issued for
12 DEC 90
Drawn by Checked by

Project No.
9015-01
Drawing Title
BUILDING
ELEVATIONS
NORTH -
SOUTH


Drawing No.
A-203

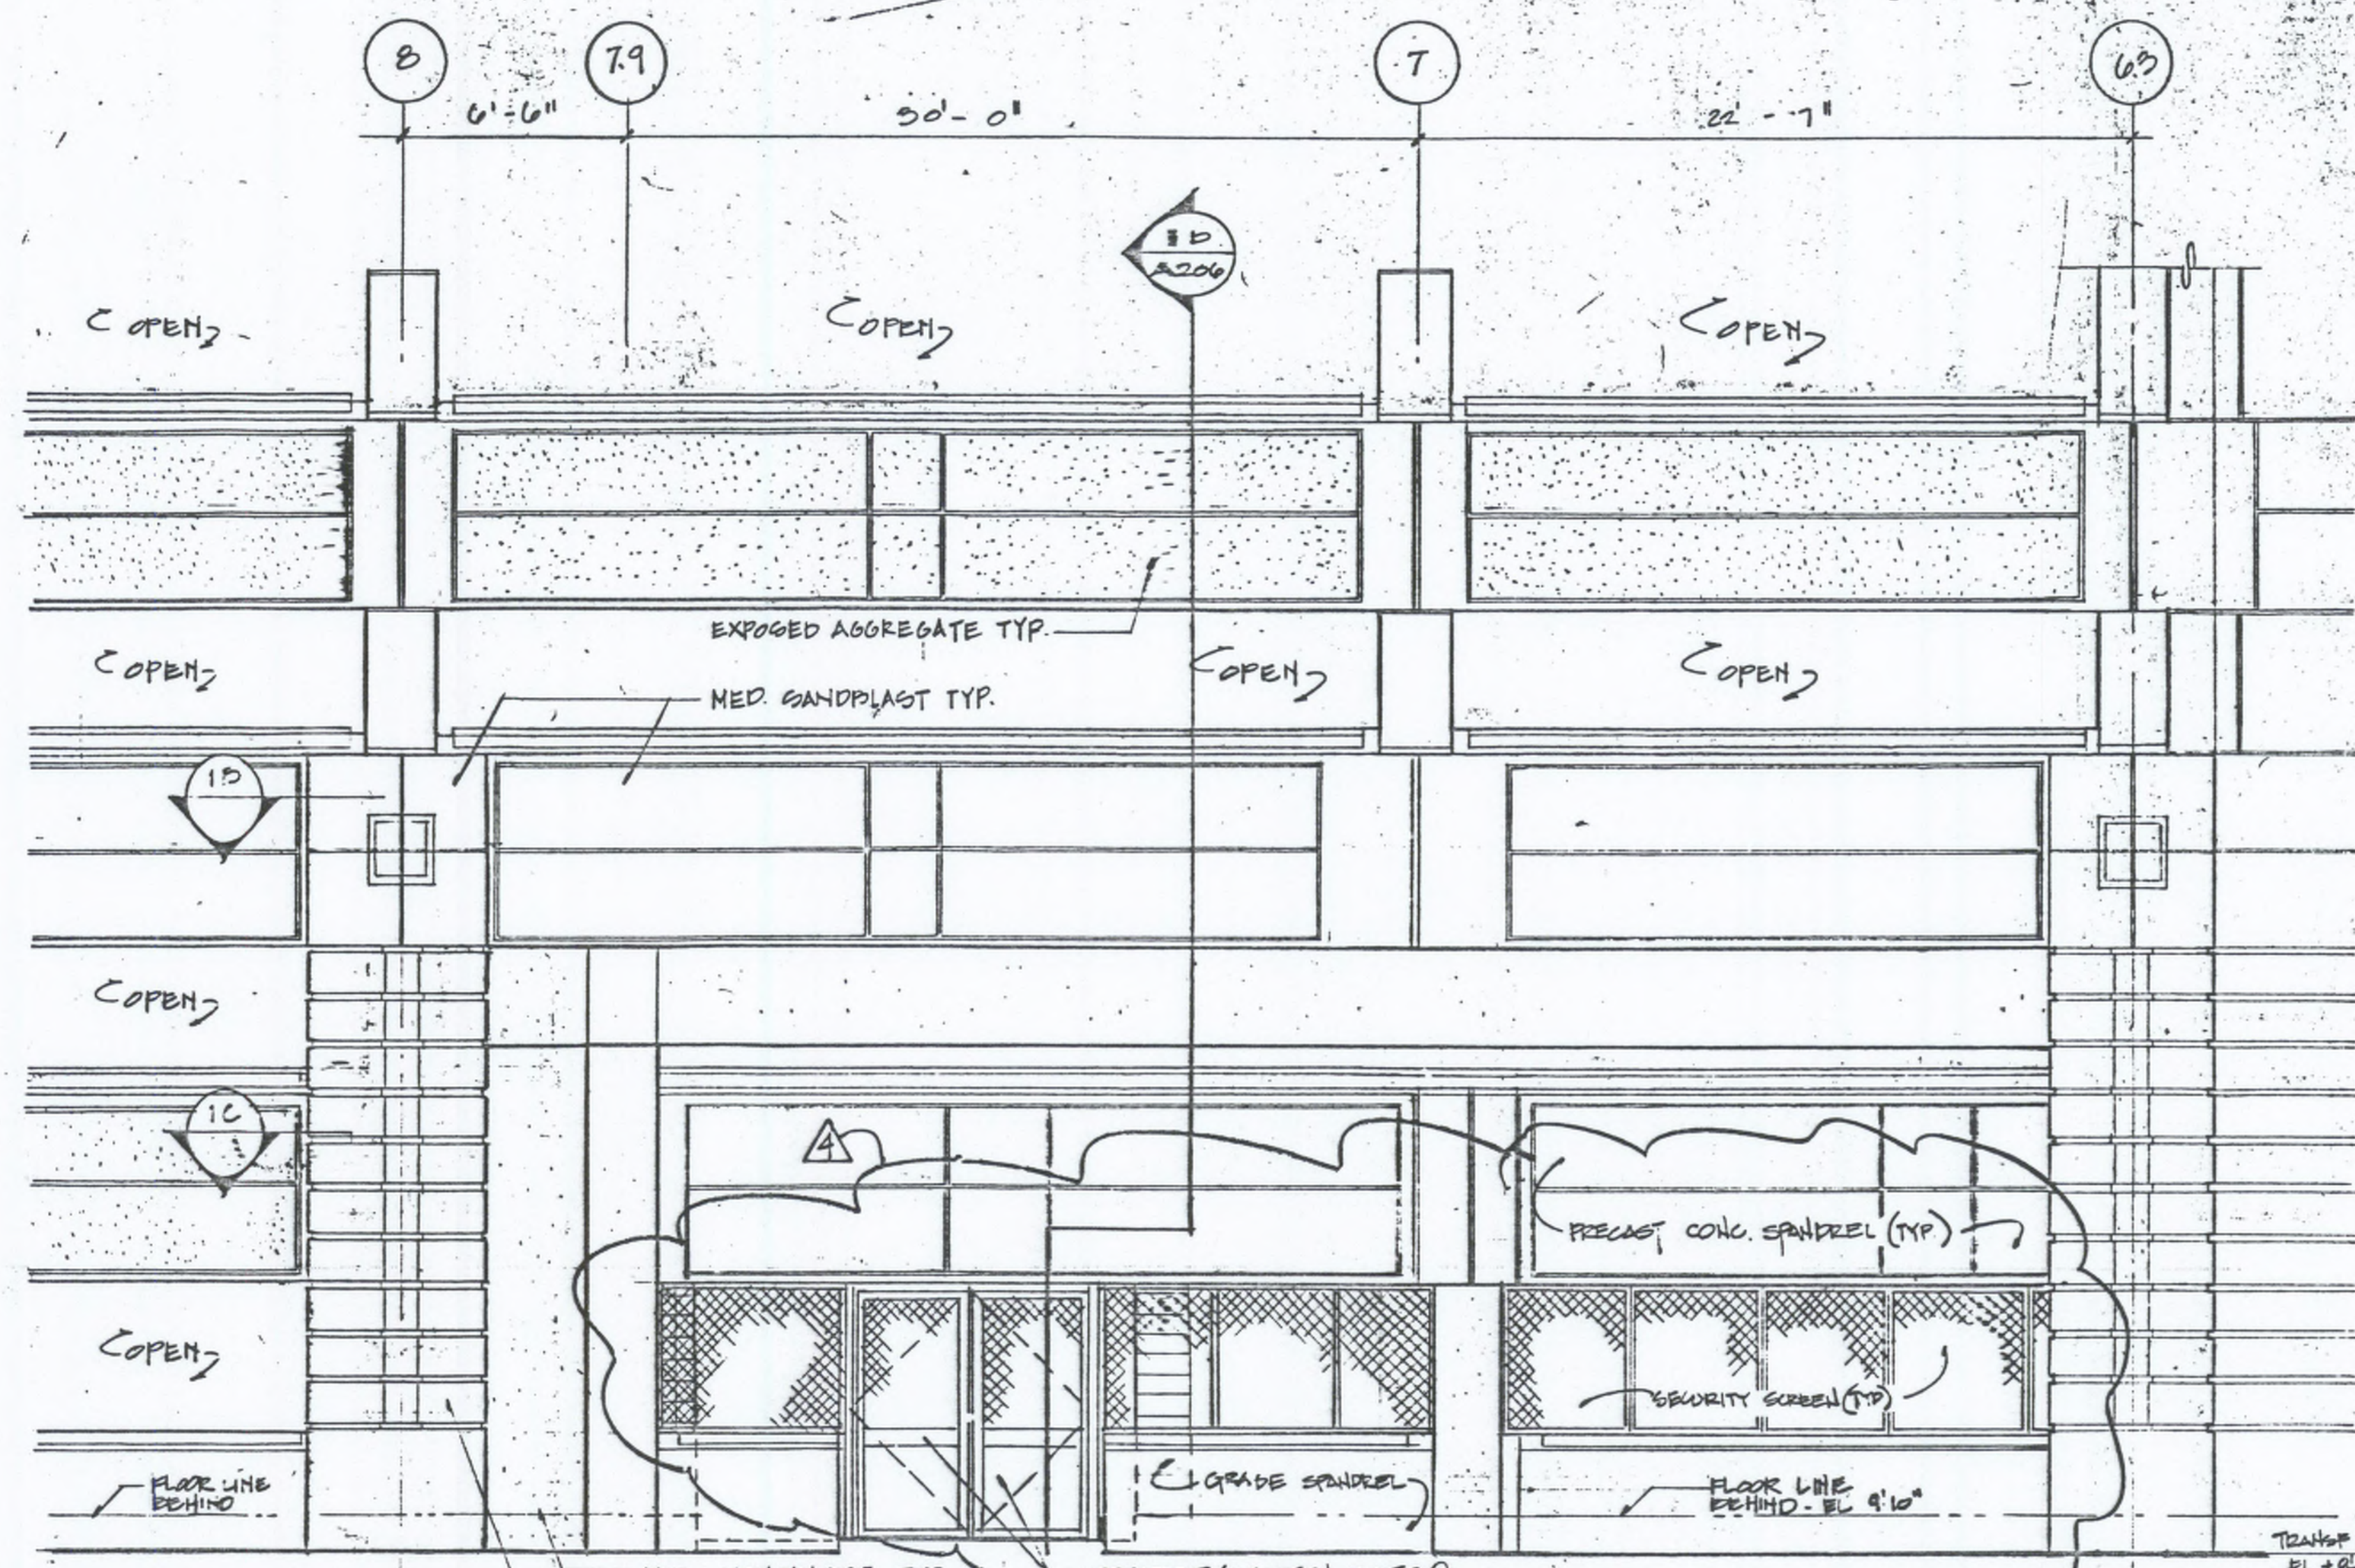


1A ELEVATION
SCALE: 1/4" = 1'-0"

1B PLAN
SCALE: 1/4" = 1'-0"

1C PLAN
SCALE: 1/4" = 1'-0"

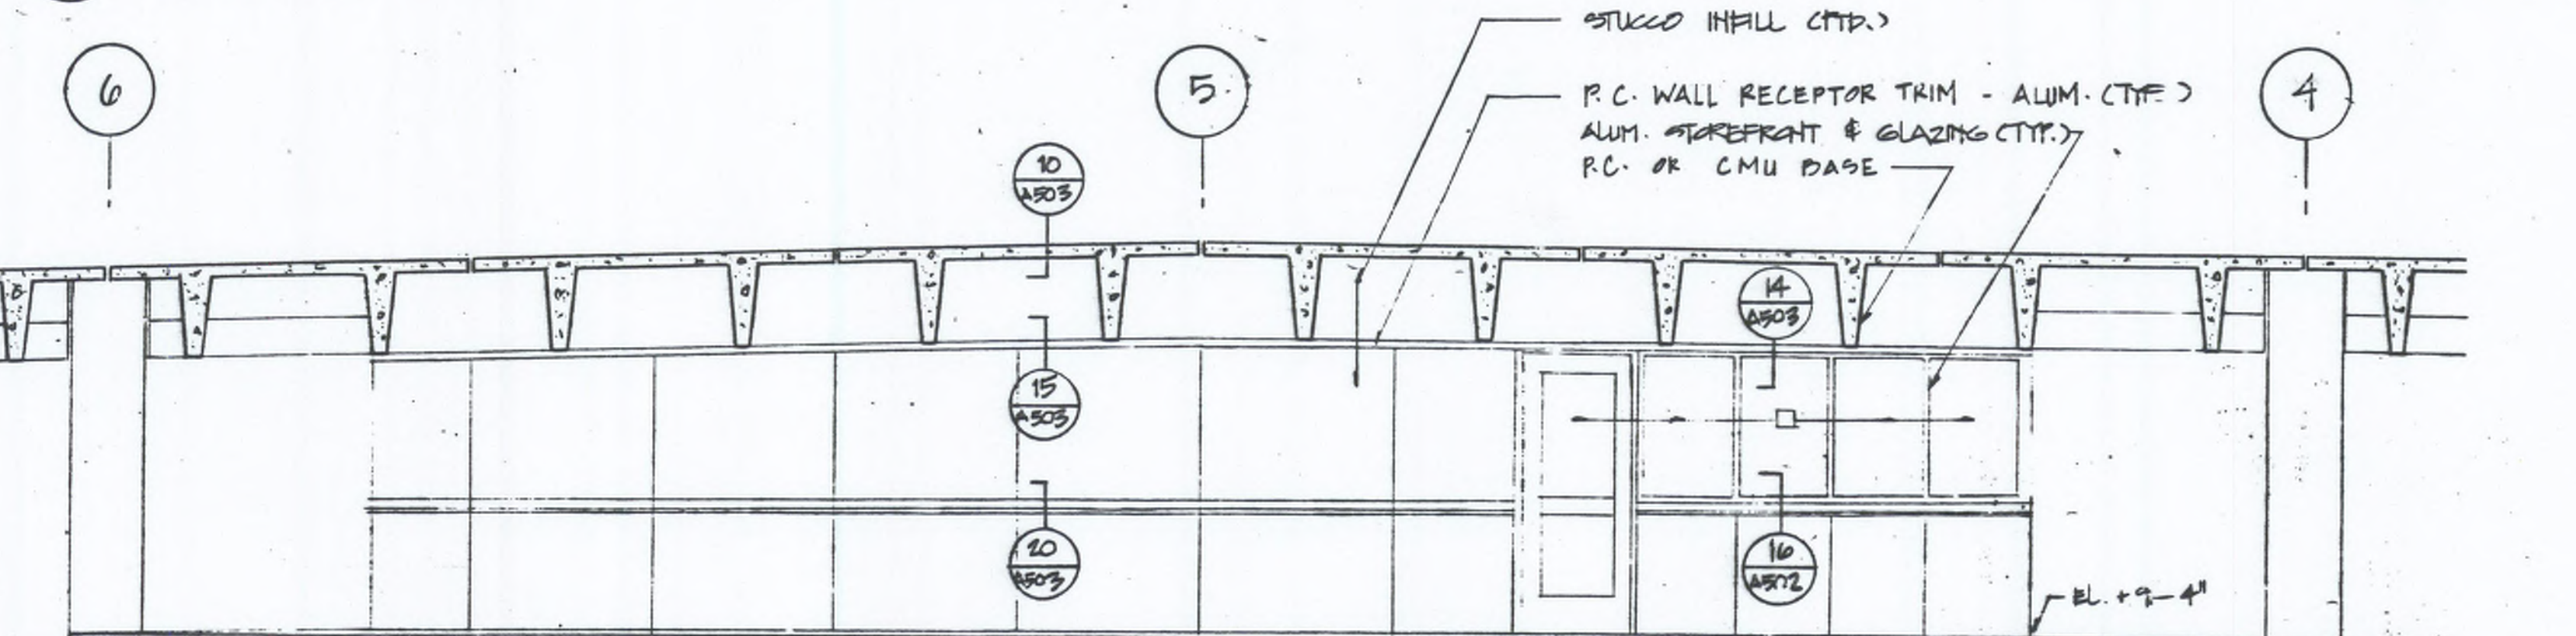


2 OFFICE: NORTH ELEVATION
SCALE: 1/4" = 1'-0"

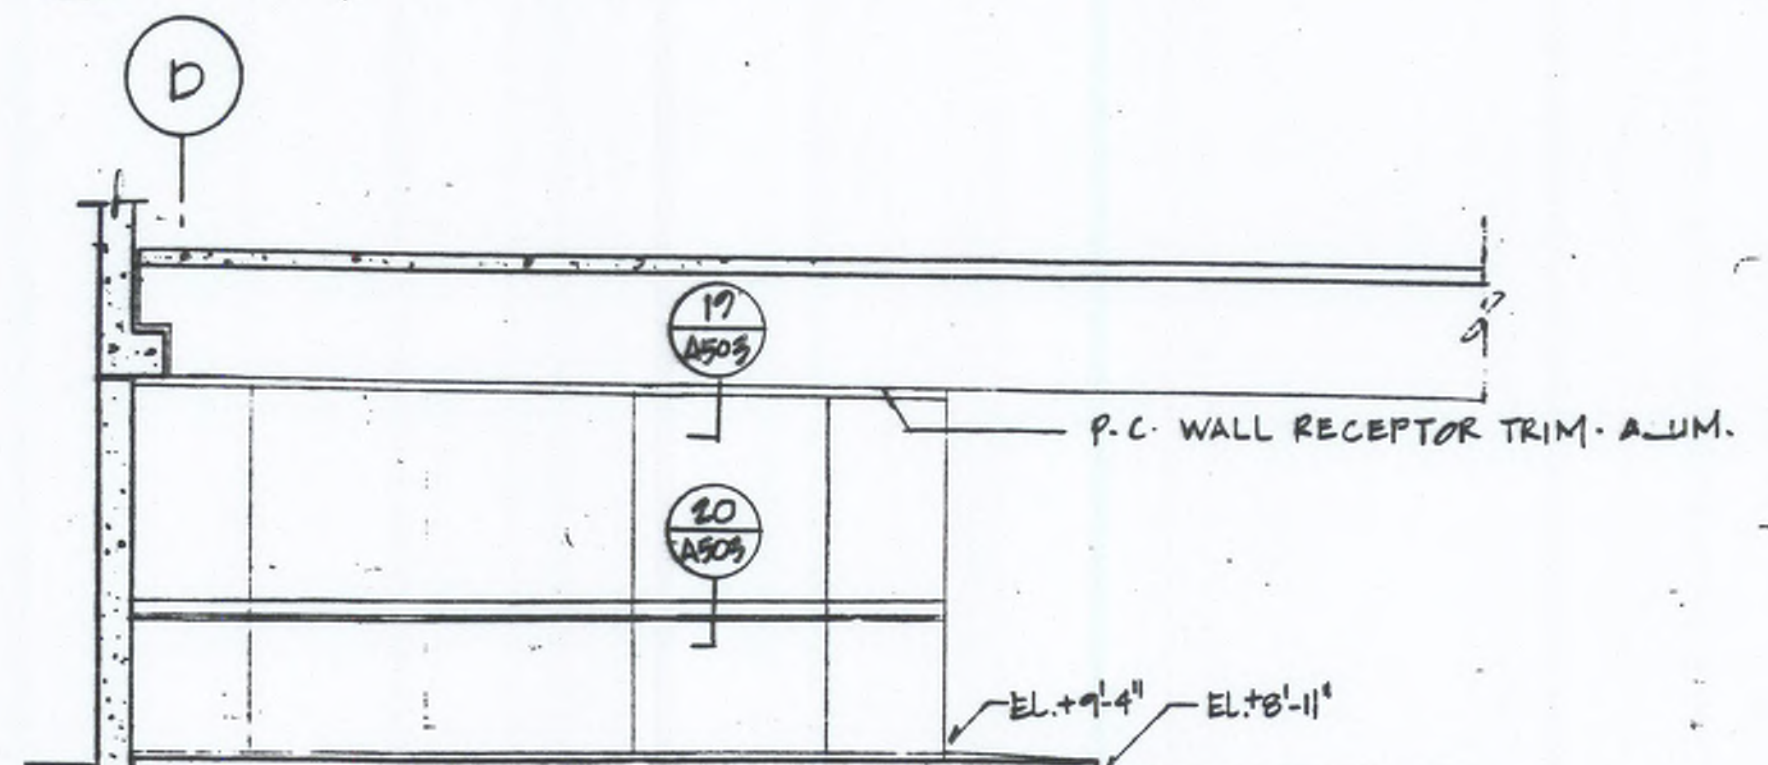


3 OFFICE: EAST ELEVATION
SCALE: 1/4" = 1'-0"




4 OFFICE: WEST ELEVATION
SCALE: 1/4" = 1'-0"

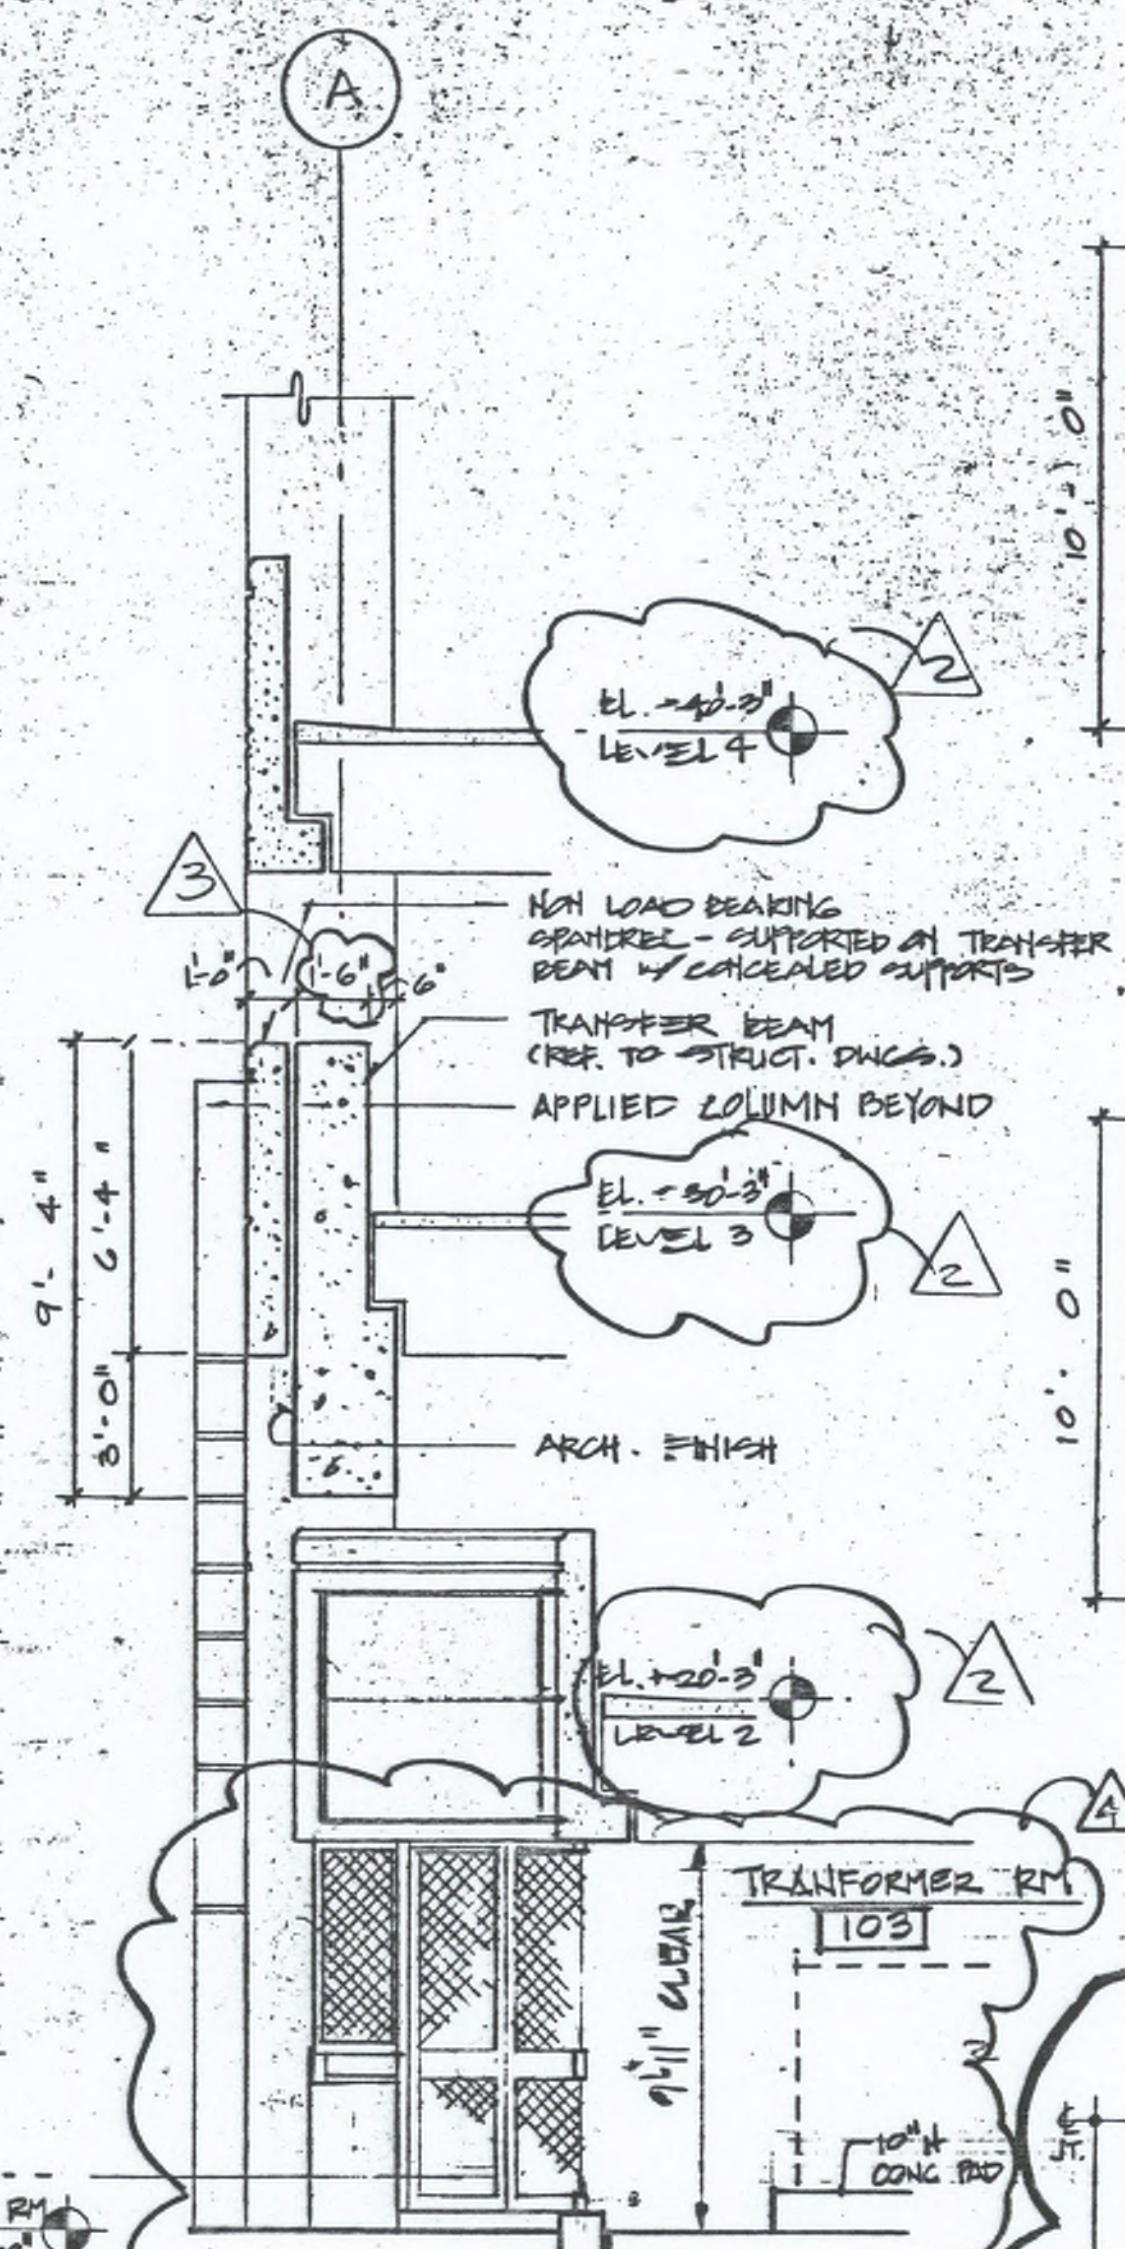


1D SECTION
SCALE: 1/4" = 1'-0"

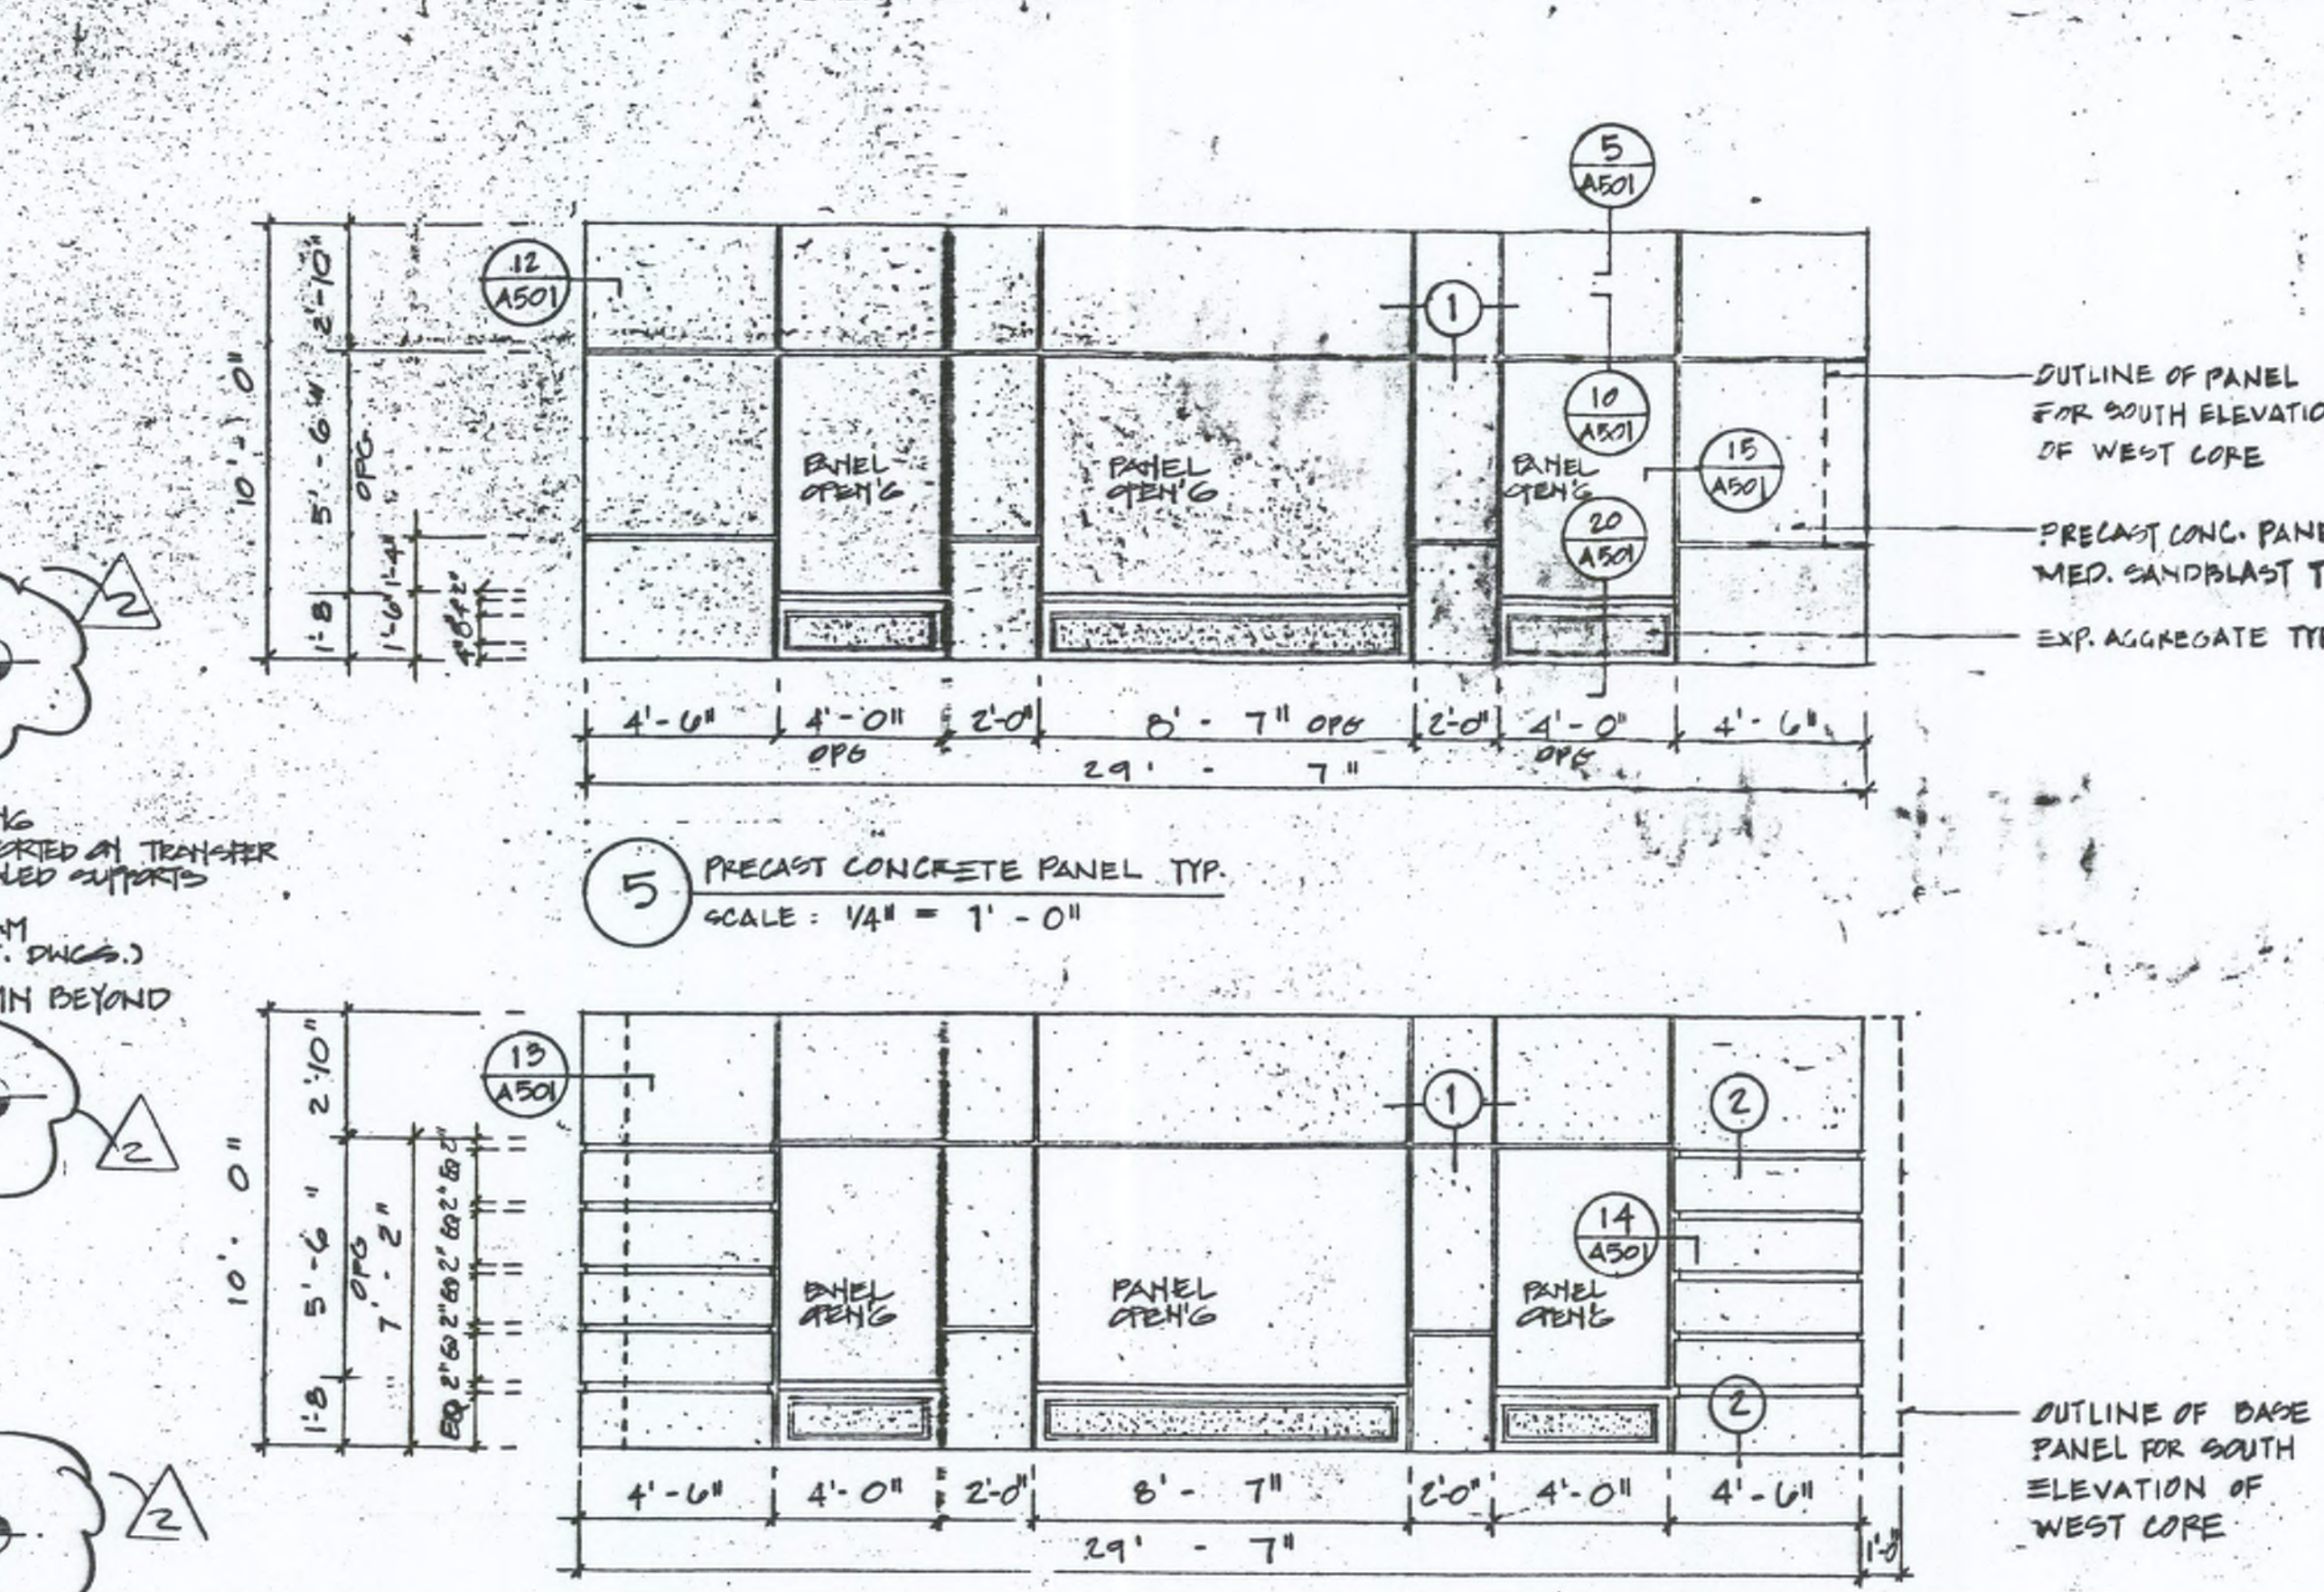


5 PRECAST CONCRETE PANEL TYP.
SCALE: 1/4" = 1'-0"

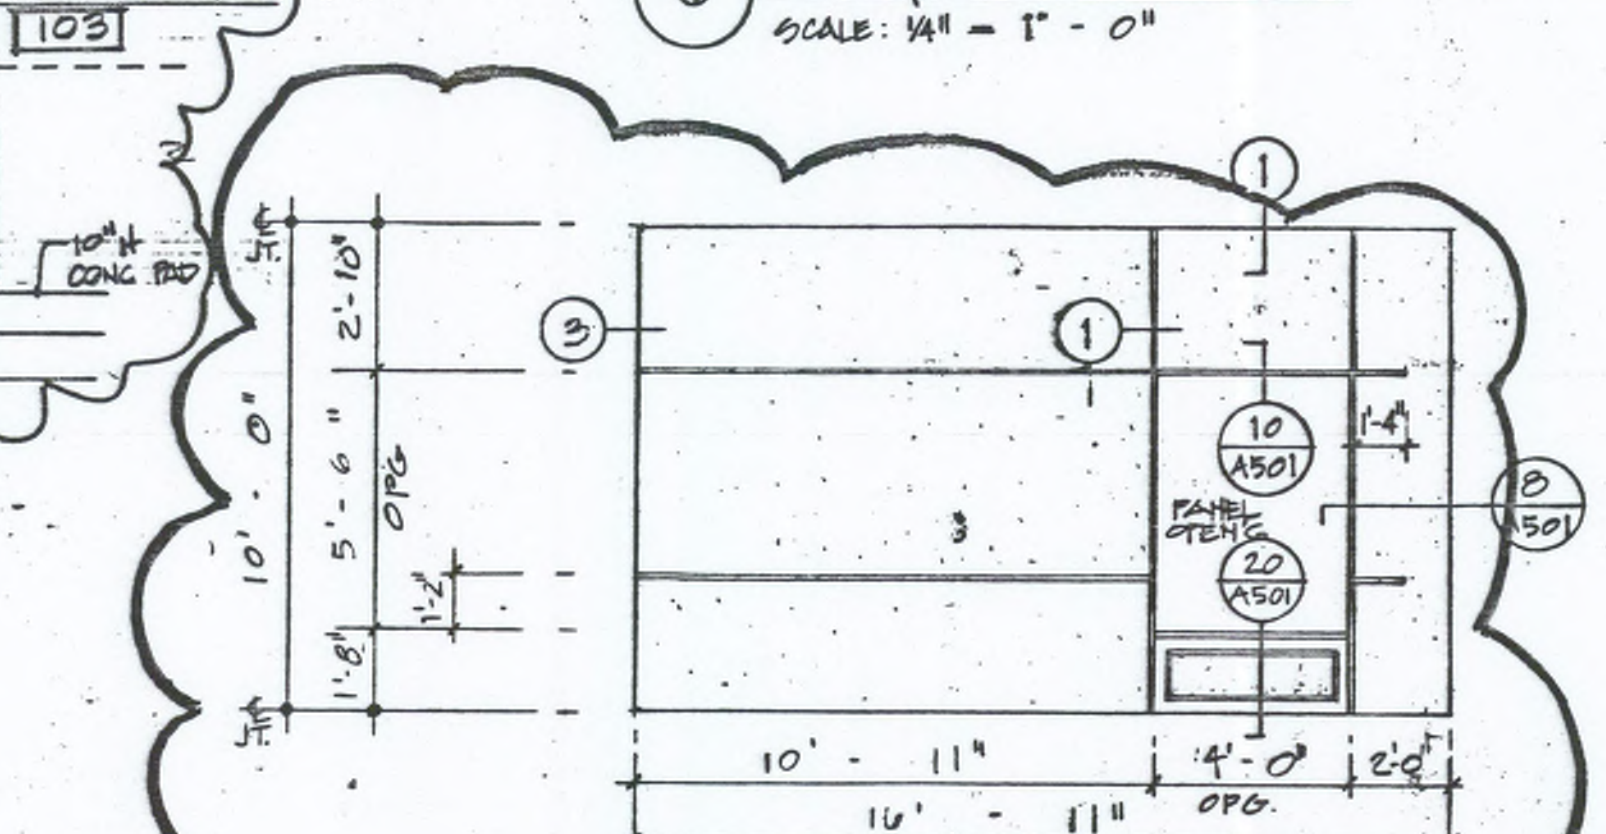

6 PRECAST CONCRETE PANEL TYP.
SCALE: 1/4" = 1'-0"

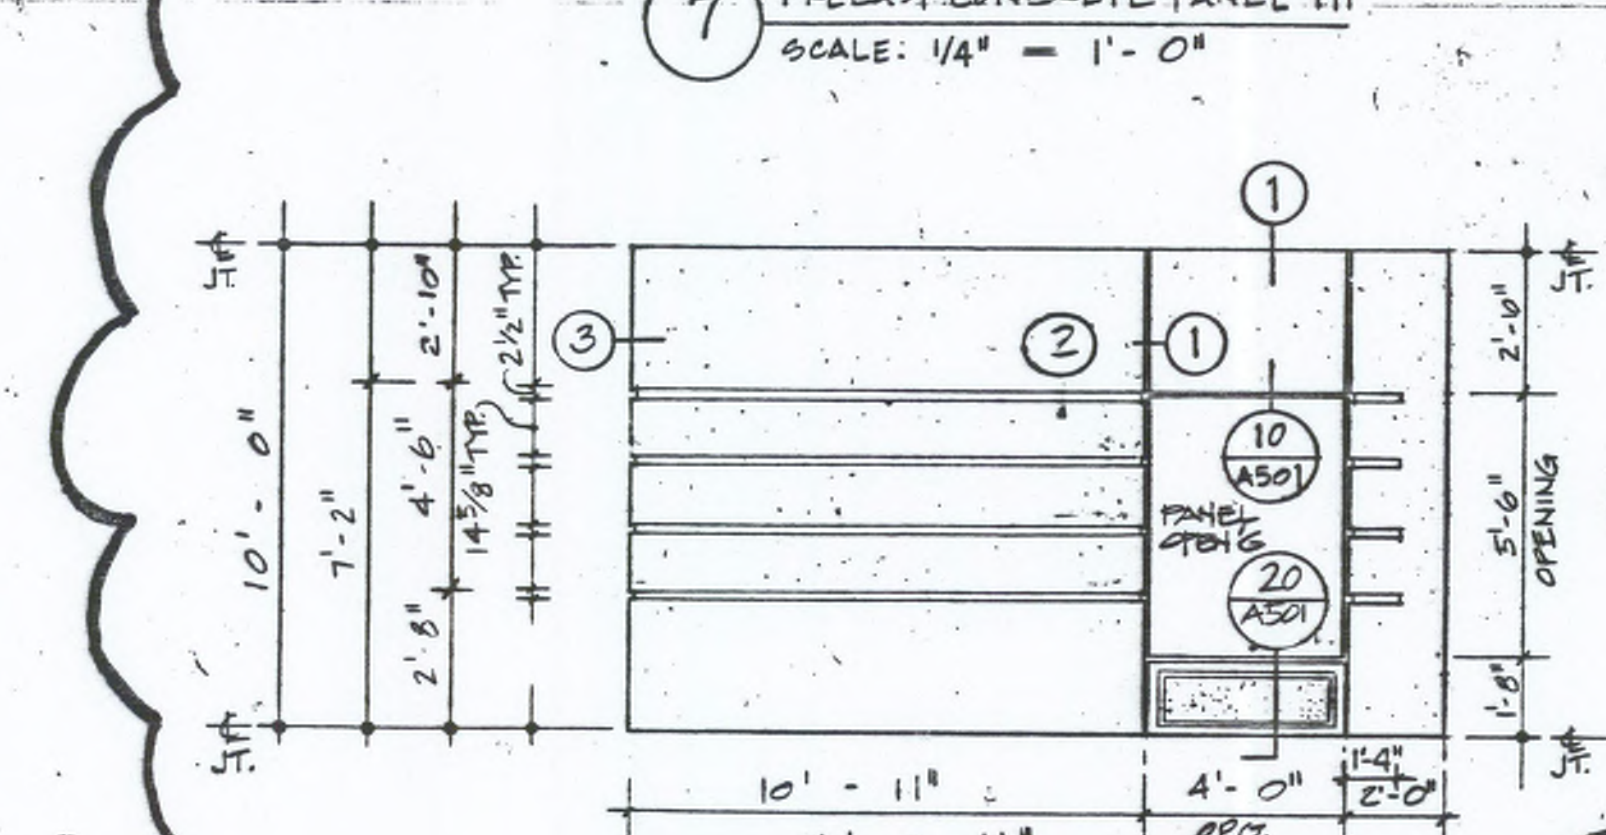


7 PRECAST CONCRETE PANEL TYP.
SCALE: 1/4" = 1'-0"

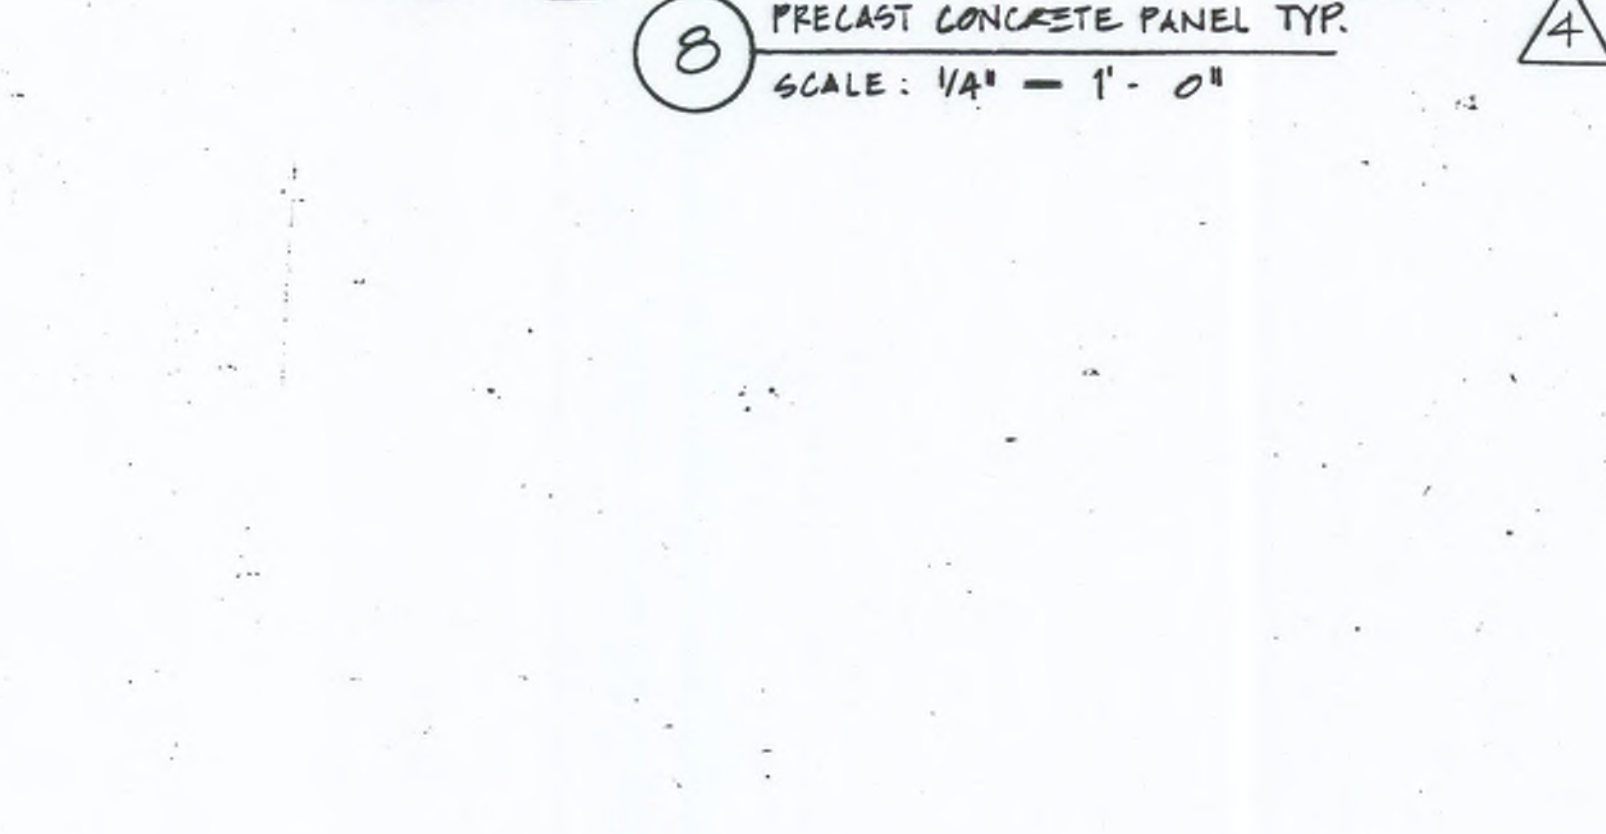


8 PRECAST CONCRETE PANEL TYP.
SCALE: 1/4" = 1'-0"




9 TYPE 1
SCALE: 1/2" = 1'-0"

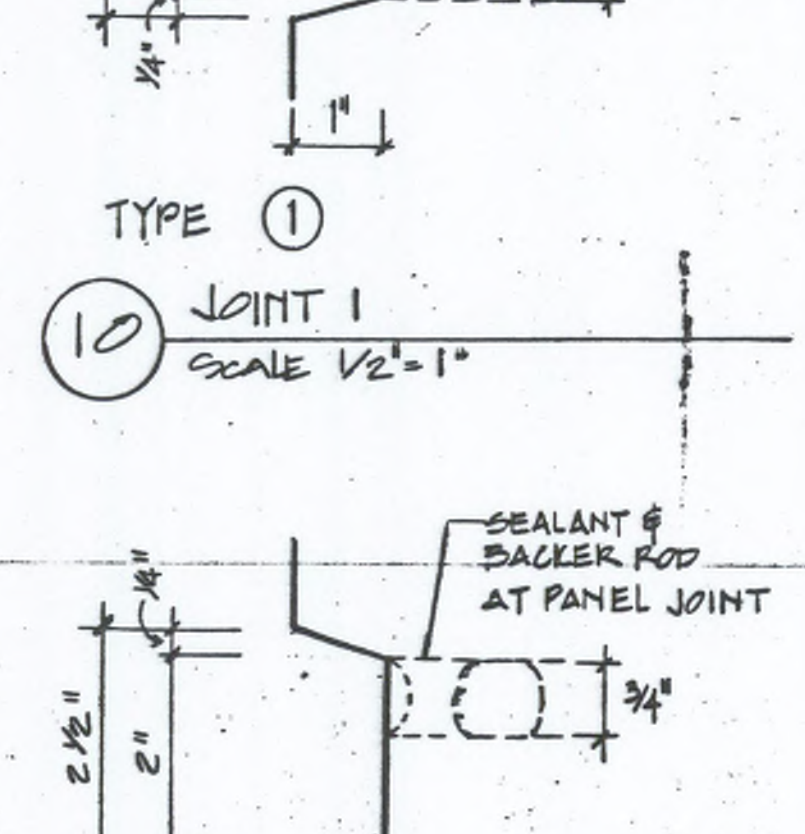


10 TYPE 2
SCALE: 1/2" = 1'-0"

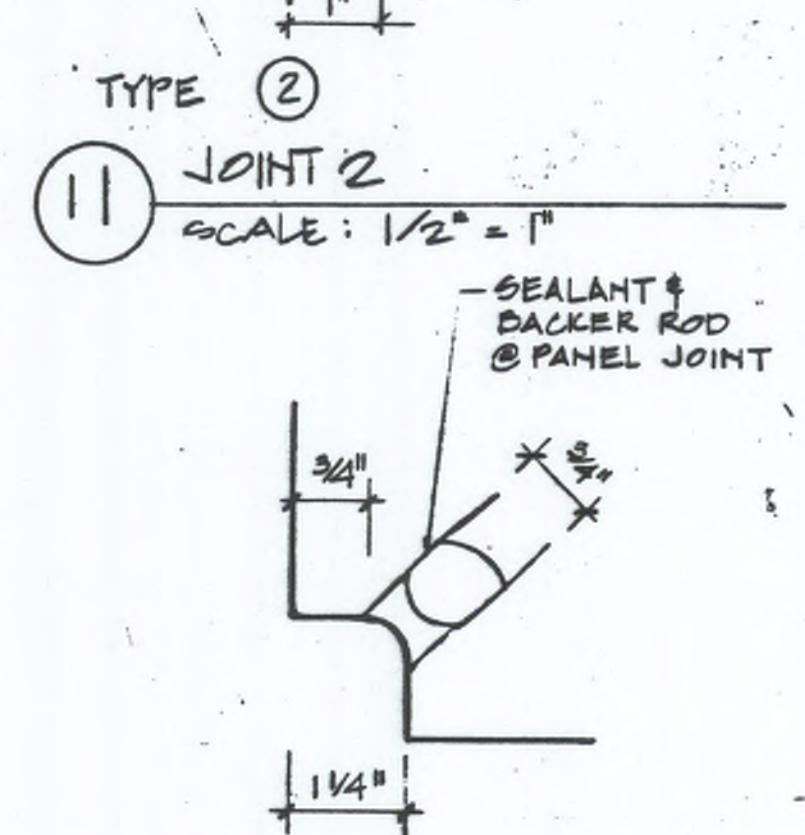

11 TYPE 3
SCALE: 1/2" = 1'-0"

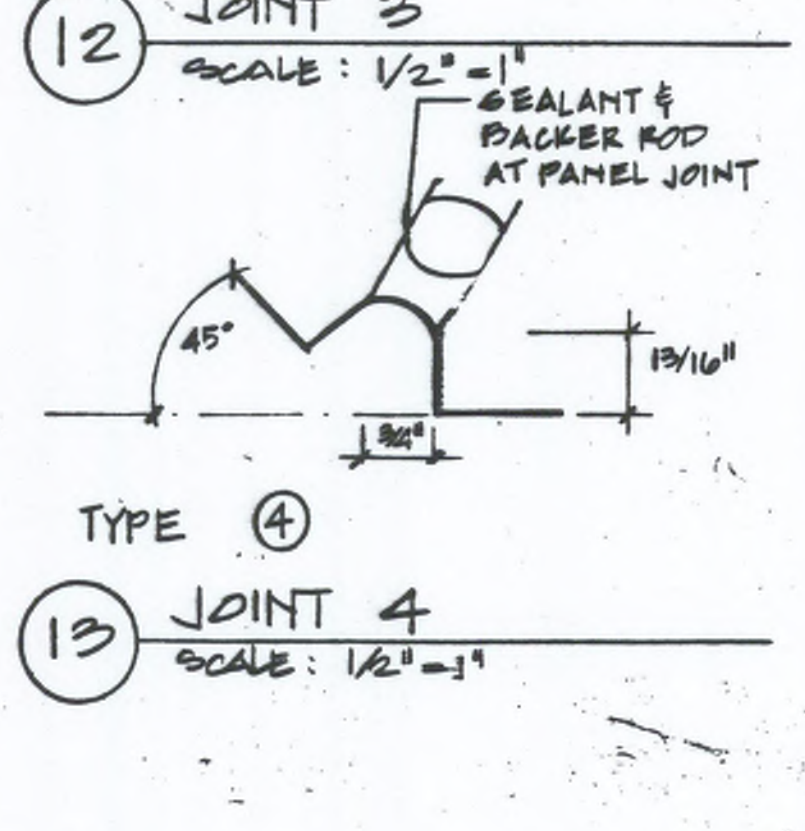

12 TYPE 4
SCALE: 1/2" = 1'-0"

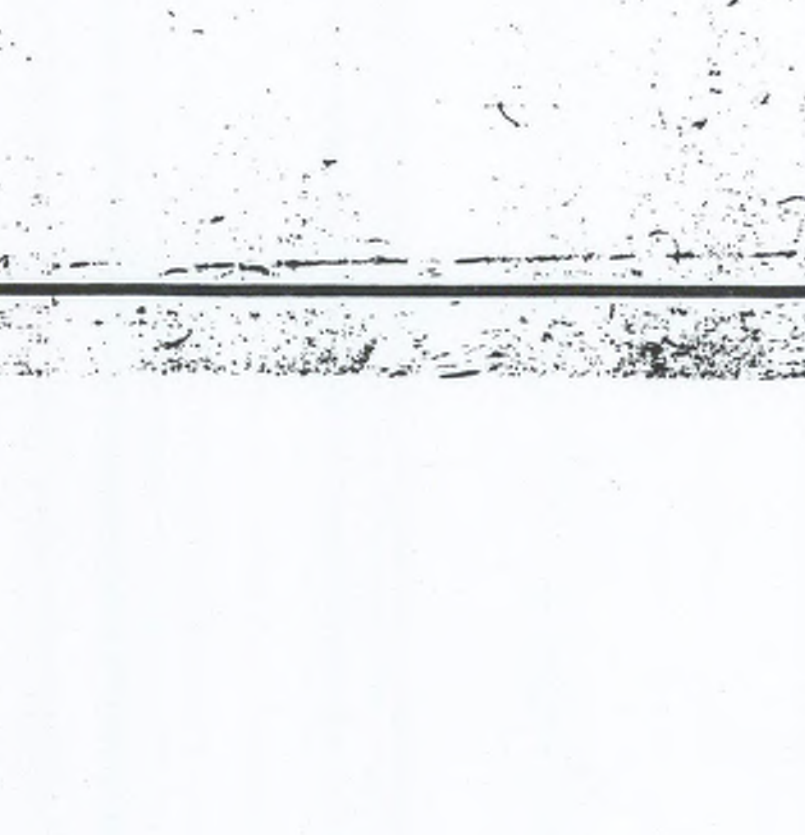

NORTH PARKING STRUCTURE

CONVENTION CENTER
PROVIDENCE
RHODE ISLAND


CONSTRUCTION MANAGER
Manning Contractors Inc.
15 Newmarket Avenue
Rumford, RI 02906
401-438-3500

Boston
Buffalo - New York
St. Louis - Washington
Cannon Boston Inc.
Architects and Engineers
146 State Street
Boston, MA 02109
617-742-5440
Fax 617-722-8832

Vannasse Hangen Brustlin Inc.
Civil Engineers/Surveyors
530 Broadway
Providence, RI 02908
401-272-9000

Desman Associates
Structural Engineers/Planning Garage Consultants
307 Fifth Avenue
New York, NY 10018
212-686-6360

The SWA Group
Landscape Architects
79 Boylston Street
Boston, MA 02116
617-266-4703

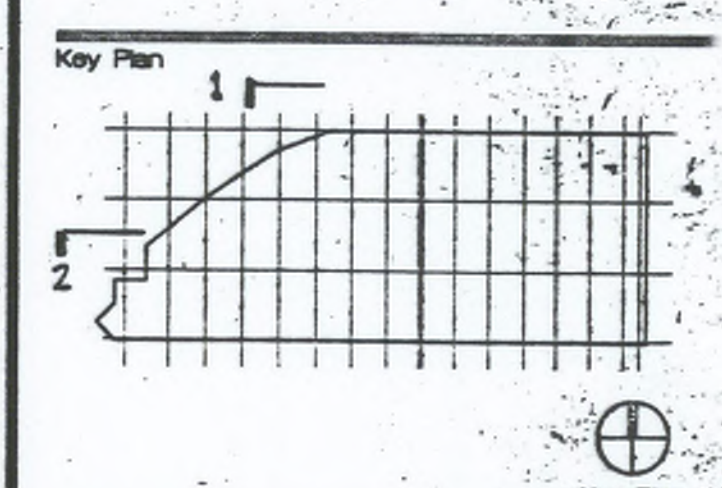

MAY 2, 1994 AS-BUILT
5 JUNE 91 BULLETIN # 5
14 FEB 91 BULLETIN # 1
Revision Date Issued for
10 DEC 90
Drawn by Checked by

Project No.
Drawing Title
BUILDING
ELEVATIONS
Drawing No.

AS206

The SWLA Group
Landscape Architects
77 Boylston Street
Boston, MA 02116
617 255-4703

REST

[illegible]